
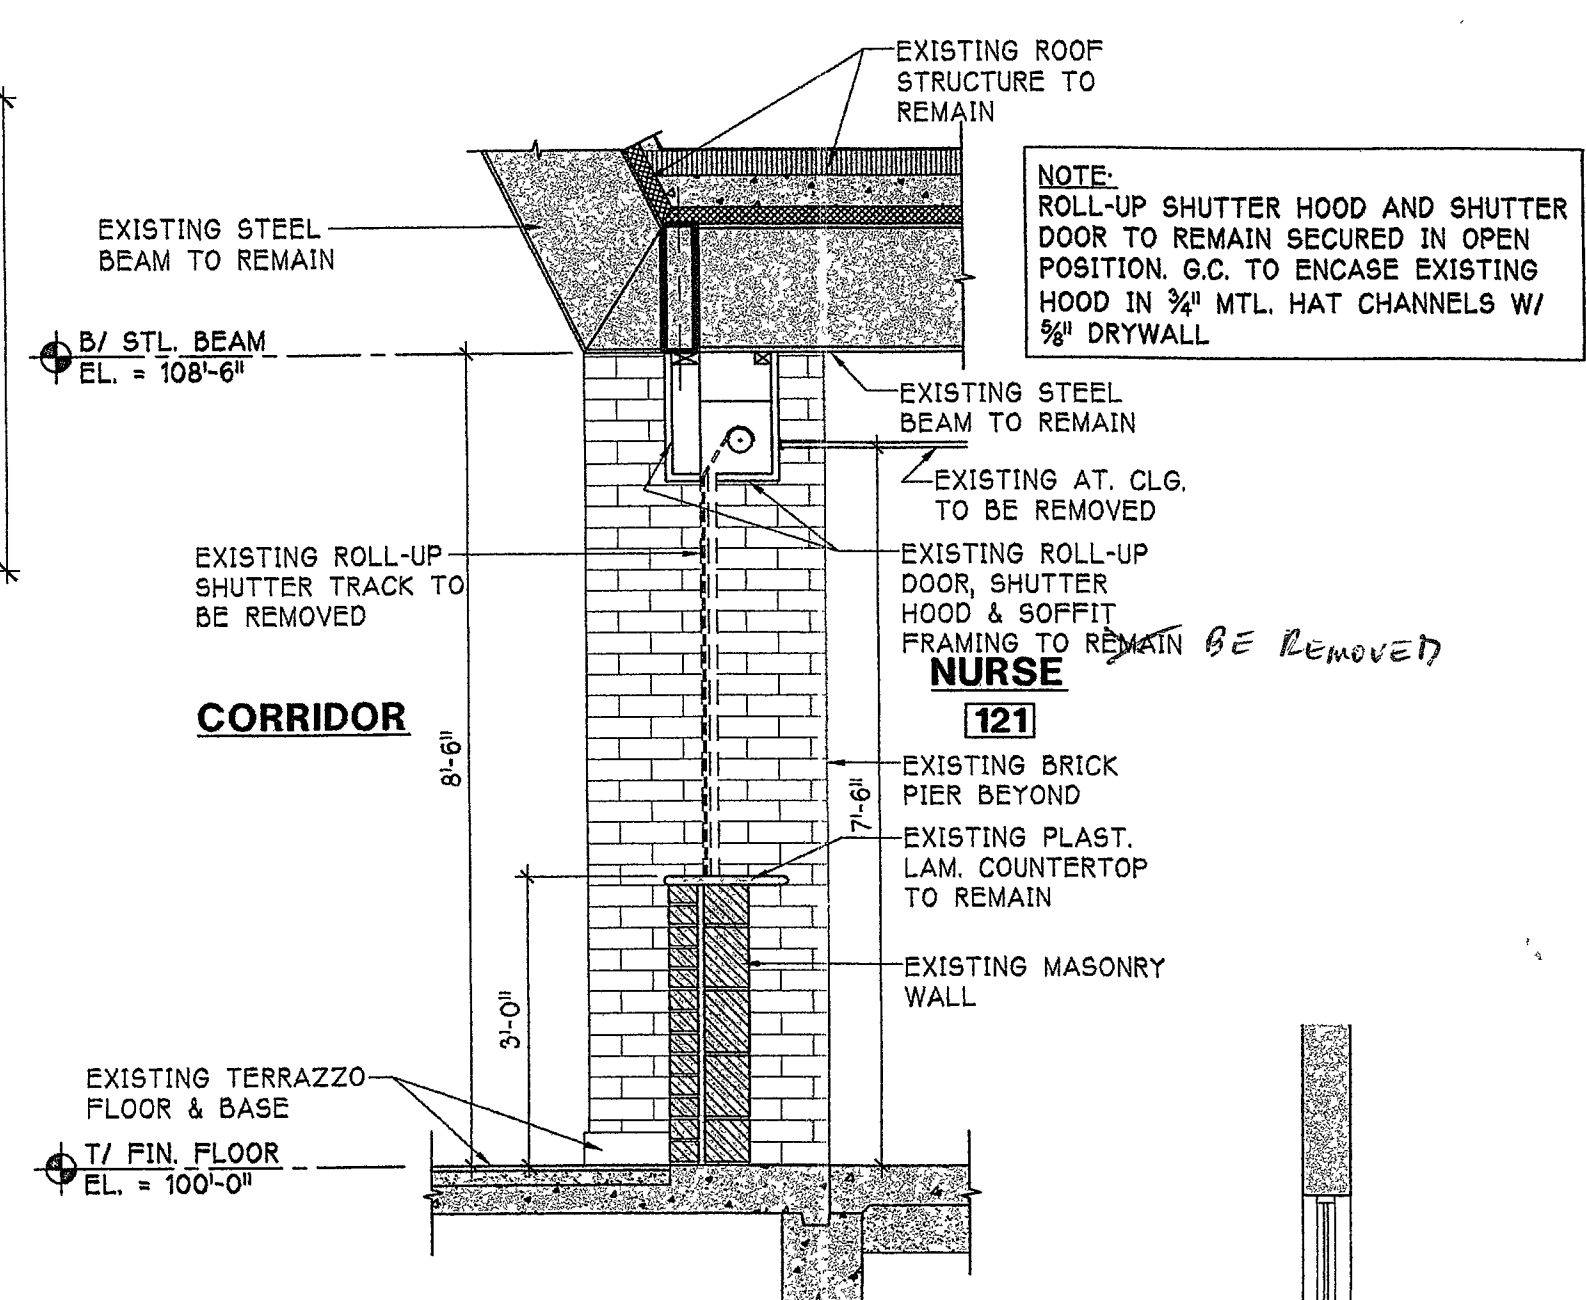



1. WHERE WALLS OR CEILINGS ARE REMOVED, CAP AS REQUIRED ALL ELECTRIC CONDUIT BOXES & WIRING, ETC. RECONNECT NEW ELECTRIC OUTLETS AND DEVICES, ETC.
2. WHERE WALLS ARE CUT OR NEW OPENING CUT-IN, OPENINGS SHALL BE PLUMB AND TRUE, NEATLY CUT. PATCH IN KIND.
3. CONTRACTOR SHALL COMPLY WITH IOSHA AND LOCAL REQUIREMENTS FOR SHORING, BRACING, ETC.
4. CONTRACTOR SHALL PROVIDE DUMPMSTER AND BE RESPONSIBLE FOR DAILY CLEAN-UP.
5. PROVIDE DUST TIGHT PARTITIONS TO PROTECT ADJACENT OCCUPIED SPACES AS REQUIRED.
6. CONTRACTOR IS SOLELY LIABLE FOR MEANS AND METHODS OF DEMOLITION AND CONSTRUCTION, PUBLIC SAFETY AND RELATED SAFETY PROGRAMS FOR THE PROJECT.
7. ALL DIMENSIONS SHOWN ARE CLOSE APPROXIMATIONS. CONTRACTOR SHALL FIELD VERIFY ALL DIMENSIONS FOR DEMOLITION AND NEW CONSTRUCTION.
8. NEATLY SAW-CUT SLAB AND TRENCH AS REQUIRED TO INSTALL NEW UNDERGROUND PLUMBING SANITARY WASTE LINES.
9. ALL LOOSE EQUIPMENT AND FURNITURE SHALL BE REMOVED FROM OFFICE SUITE BY OWNER PRIOR TO DEMOLITION.

1. REMOVE INTERIOR WALL FROM ROOF DECK DOWN TO FLOOR SLAB CAP AND/OR EXTEND ELECTRIC CIRCUITS AND WIRING, PLUMBING AND DUCTWORK AS REQUIRED.
2. REMOVE DOOR AND FRAME
3. STRIP EXISTING FLOOR COVERING (TILE OR CARPET) AND CLEAN CONCRETE SLAB. PREP AS REQUIRED FOR NEW FLOOR COVERING
4. REMOVE EXISTING CEILING TILE AND GRID OR DRYWALL TO EXPOSE EXISTING STRUCTURE. REMOVE LIGHT FIXTURES, HVAC GRILLES AND DIFFUSERS, SPEAKERS, SMOKE DETECTORS, ETC.
5. REMOVE EXISTING DOOR, SIDELITE AND/OR BORROWED LITE. SALVAGE AS DIRECTED BY OWNER.
6. REMOVE EXISTING COUNTERTOP AND CASEWORK
7. REMOVE EXISTING PLUMBING FIXTURES CAP WASTE AND WATER LINES. REUSE WASTE AND VENT LINES AS POSSIBLE WHERE NEW FIXTURES INSTALLED IN PROXIMITY TO THOSE REMOVED
8. REMOVE EXISTING TOILET PARTITIONS.

- 9 REMOVE EXISTING ROLL-UP SHUTTER DOOR AND FRAME.
EXISTING COUNTERTOP TO REMAIN.
- 10 CUT-IN OPENING FOR NEW 4x4" WINDOW. PATCH BLOCK JAMBS
AS REQUIRED AND INSTALL LINTEL
- 11 EXISTING ROOF DRAIN TO BE RELOCATED. DRYWALL ENCLOSURE
TO BE REMOVED INCLUDE SLAB CUT AND PATCH
- 12 REMOVE (2) METAL SHELVING UNITS, SALVAGE AND GIVE TO
OWNER. CAREFULLY CUT CORIAN COUNTERTOP AND SEAL TO
NEW WALL
- 13 SALVAGE EXISTING NURSE'S BASE AND WALL CABINETS, S S
COUNTERTOP, AND SINK FOR REUSE IN NEW NURSE'S ROOM 121.
- 14 REMOVE EXISTING CONCRETE VAULT WALLS, CEILING, FLOOR
FINISHES, AND VAULT DOOR AND FRAME
- 15 SAW-CUT AND REMOVE EXISTING CONCRETE FLOOR SLAB TO
BUILD NEW TOILET ROOMS AS SHOWN ON ARCHITECTURAL PLAN
ON DRAWING A11
- 16 SLOT CONC SLAB FOR NEW 1 1/2" DRAIN LIN FOR NEW SINK (INTO
CORRIDOR TUNNEL)
- B Drawings
* Sheet A1 0 - Demolition
- 1 See Attached floor plan for clarifications as follows
- a Both east and west walls to be removed at Existing Nurse's Office are CMU
with plaster skim coat
- b East wall of Main Office to be removed is CMU with plaster skim coat
- 2 Flooring Removal Notes
- a Typically, in carpeted areas, vinyl asbestos tile was previously removed
- b Where old 9"x9" VA tile remains, abate and remove by GC (Guidance Officer,
and Offices #1 and #2, and adjacent corridor)
- * VA Tile denotes Vinyl Asbestos Tile
- ADD #1 5 MAY 11

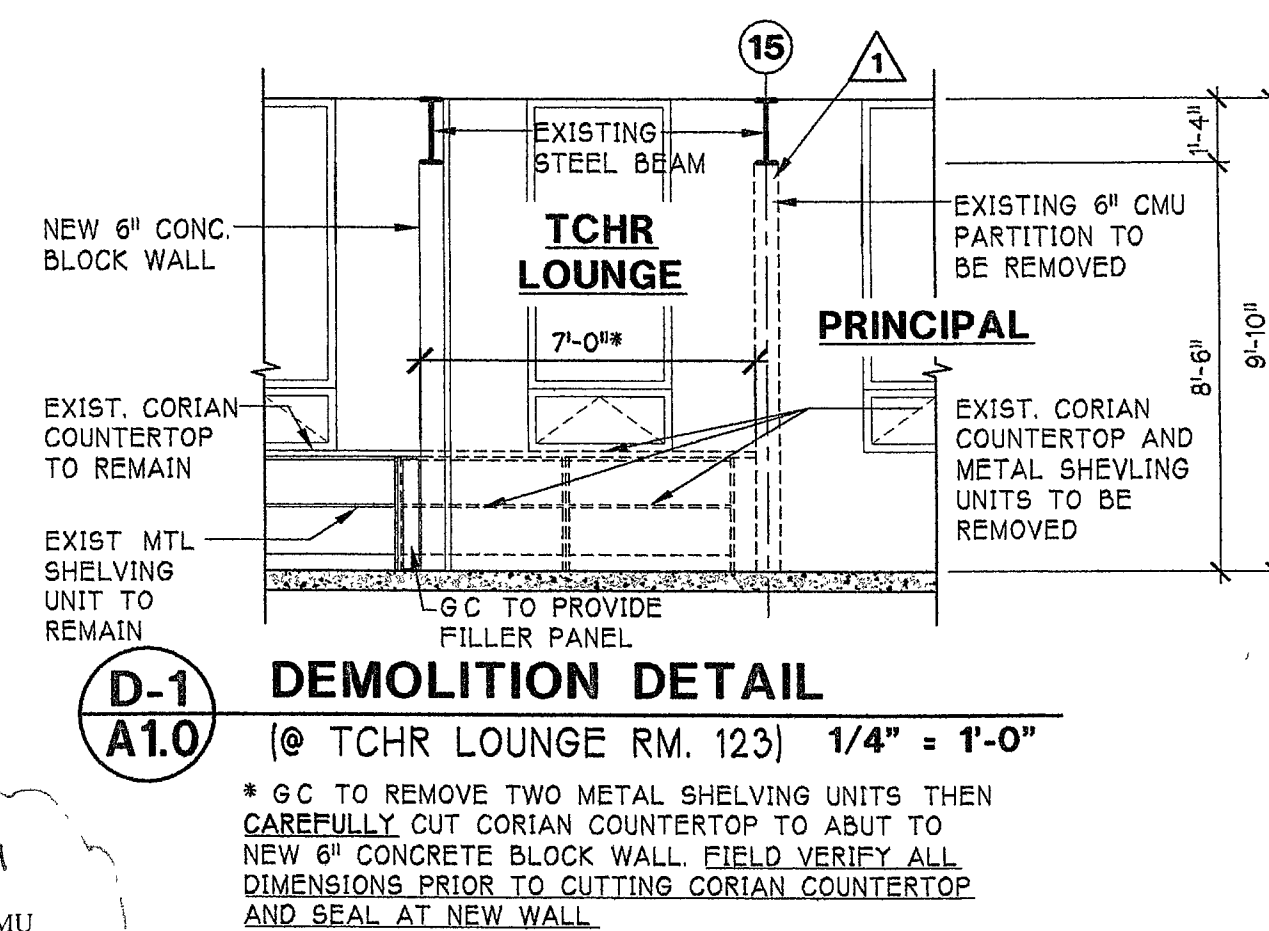

D-2 DEMOLITION WALL SECTION
A1.0 (@ NURSE ROLL-UP SHUTTER) 1/2" = 1'-0"

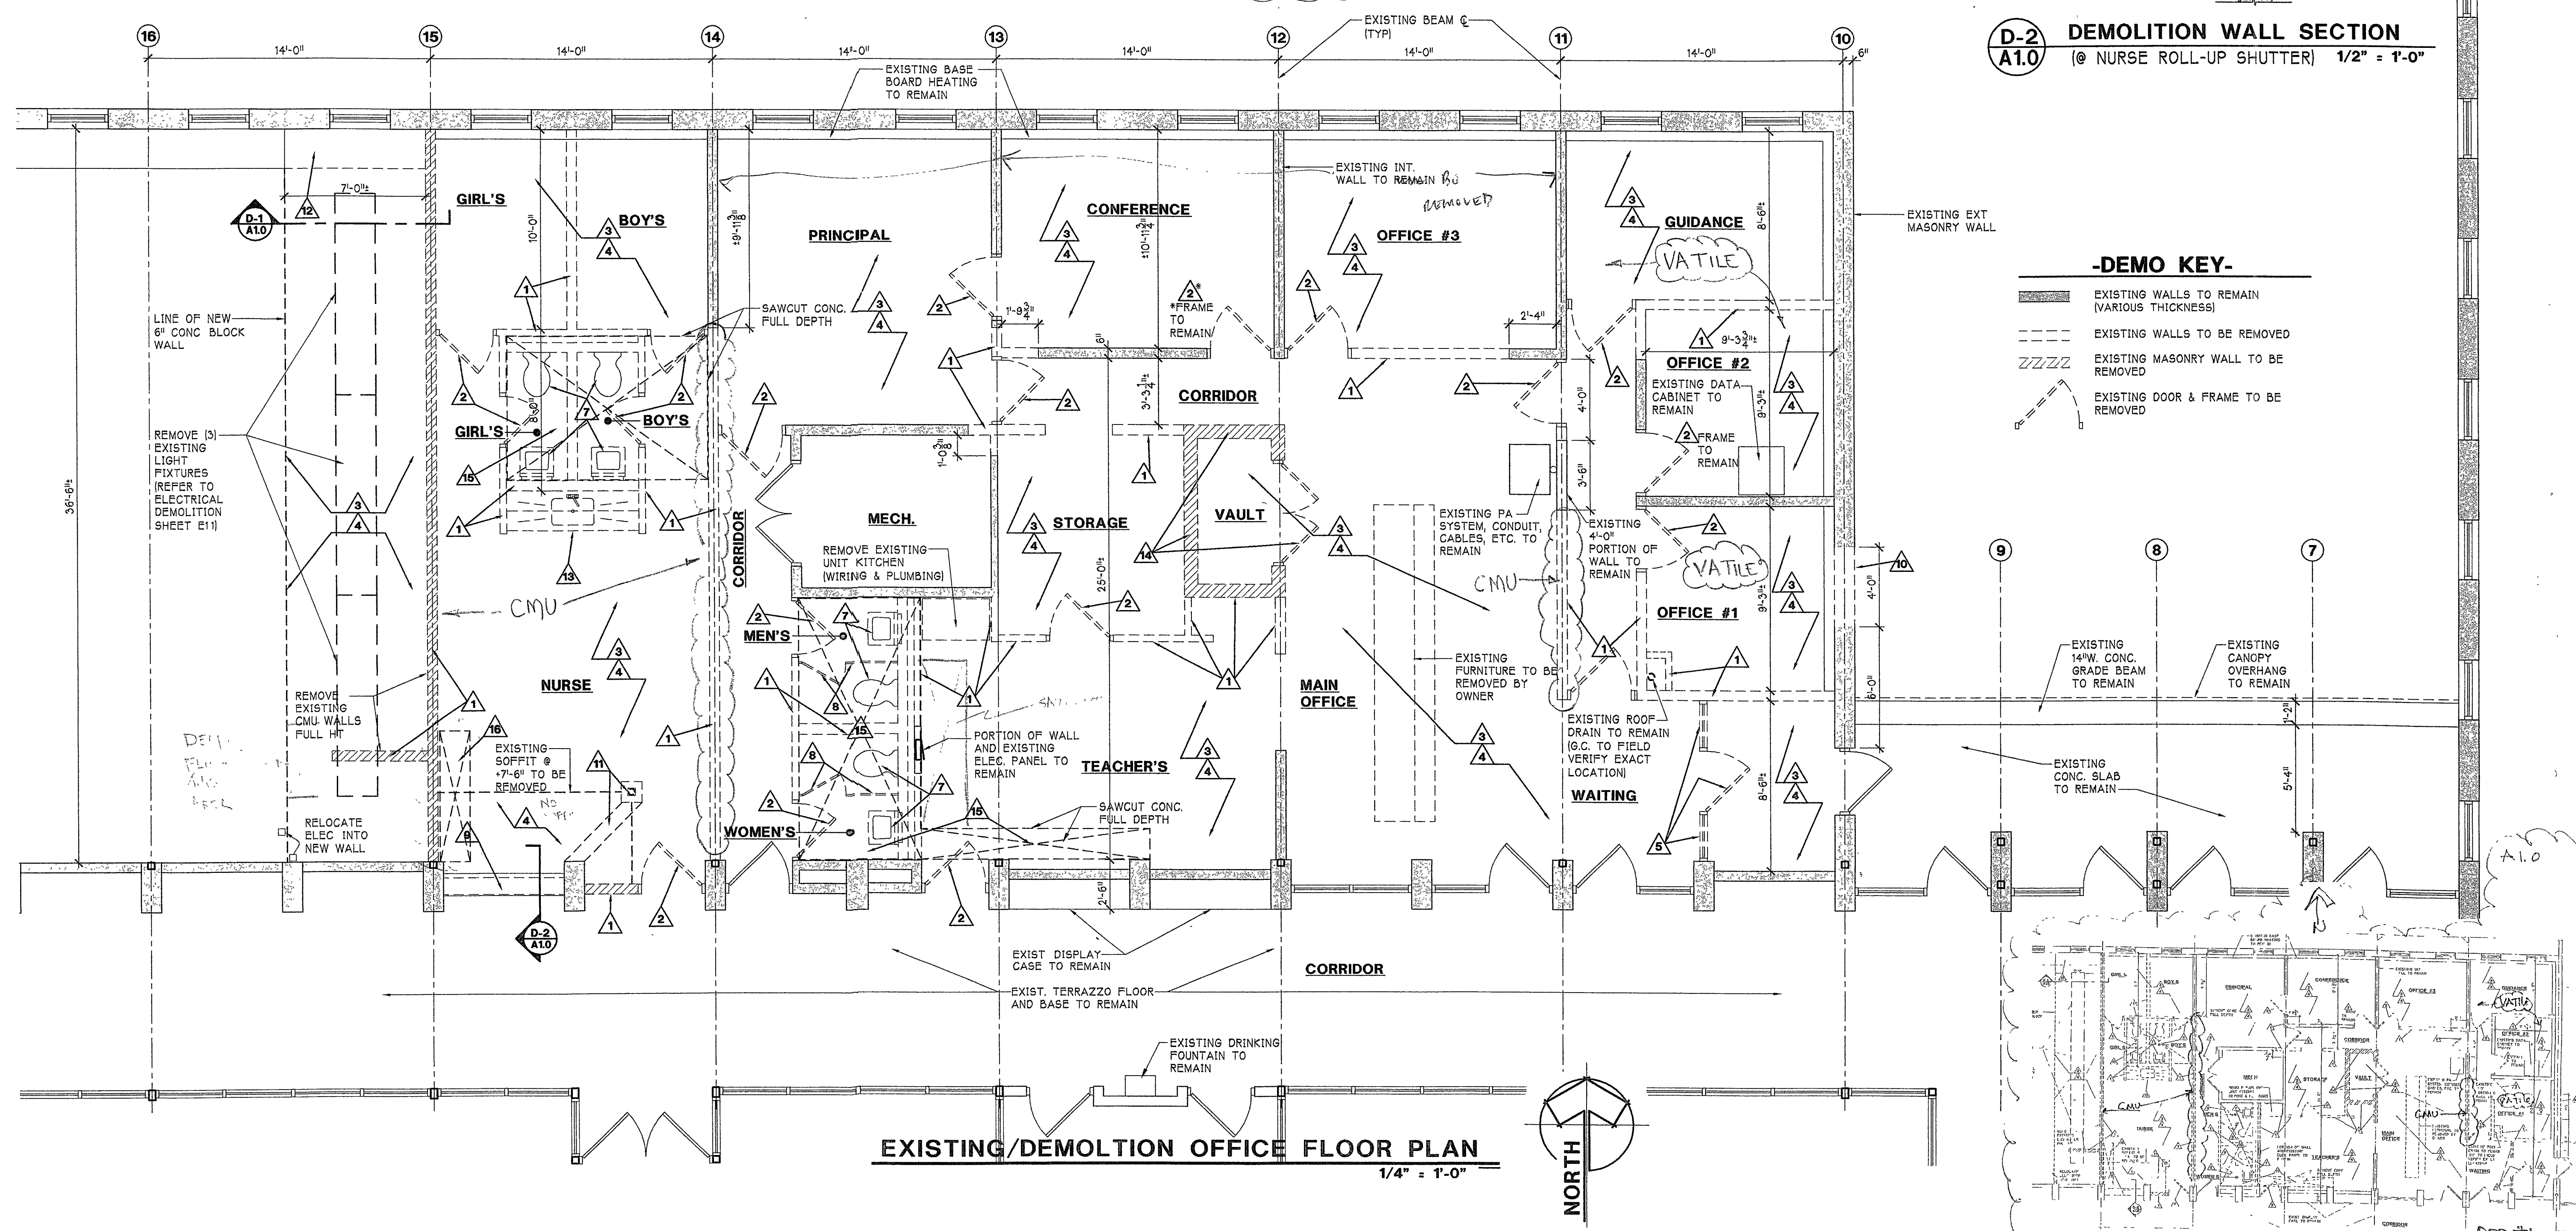[illegible]