



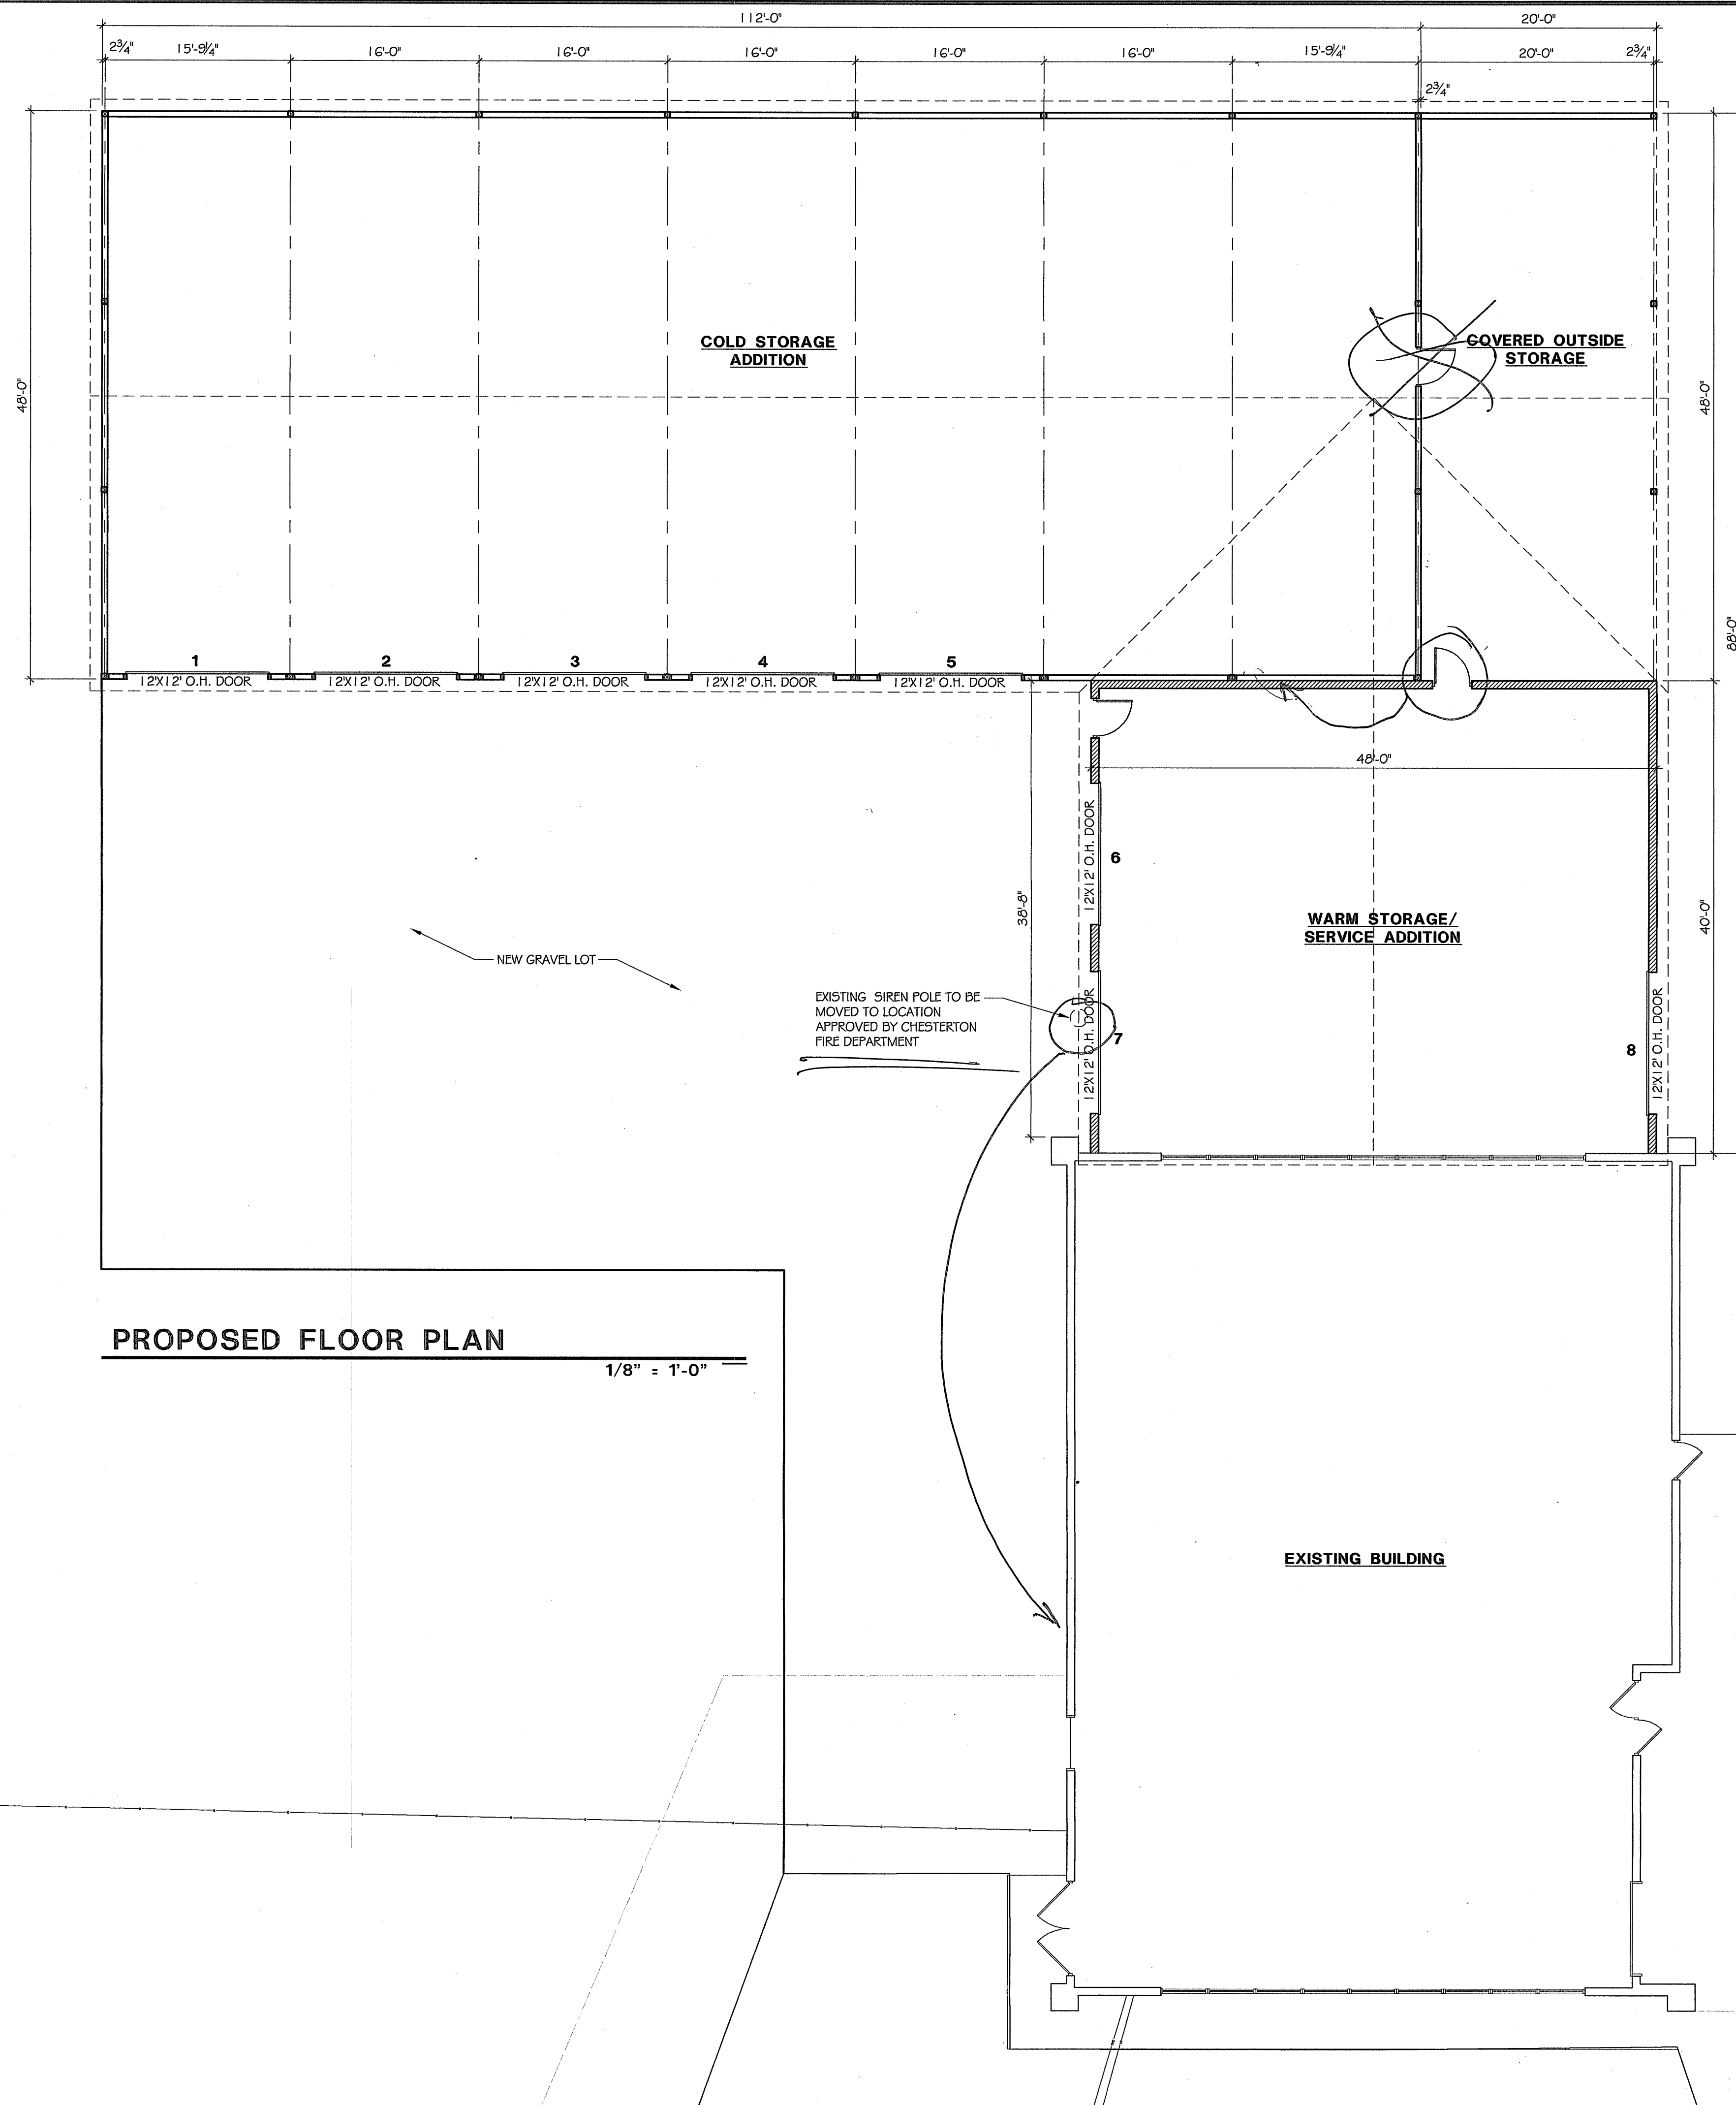

REVISIONS	BY

PROPOSED MAINTENANCE BUILDING FLOOR PLAN
WESTCHESTER MAINTENANCE BUILDING
1050 S. FIFTH STREET
CHESTERTON, INDIANA
gerometta & kinel architects, inc.
chesterton, indiana

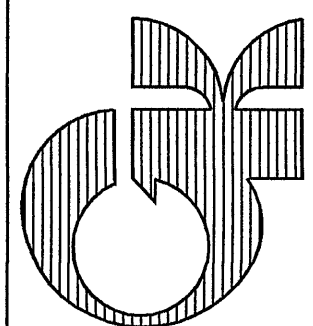

DATE	7/8/11
SCALE	AS NOTED
DRAWN	JAV
JOB	1118
SHEET	A1.1

OF X SHEETS