



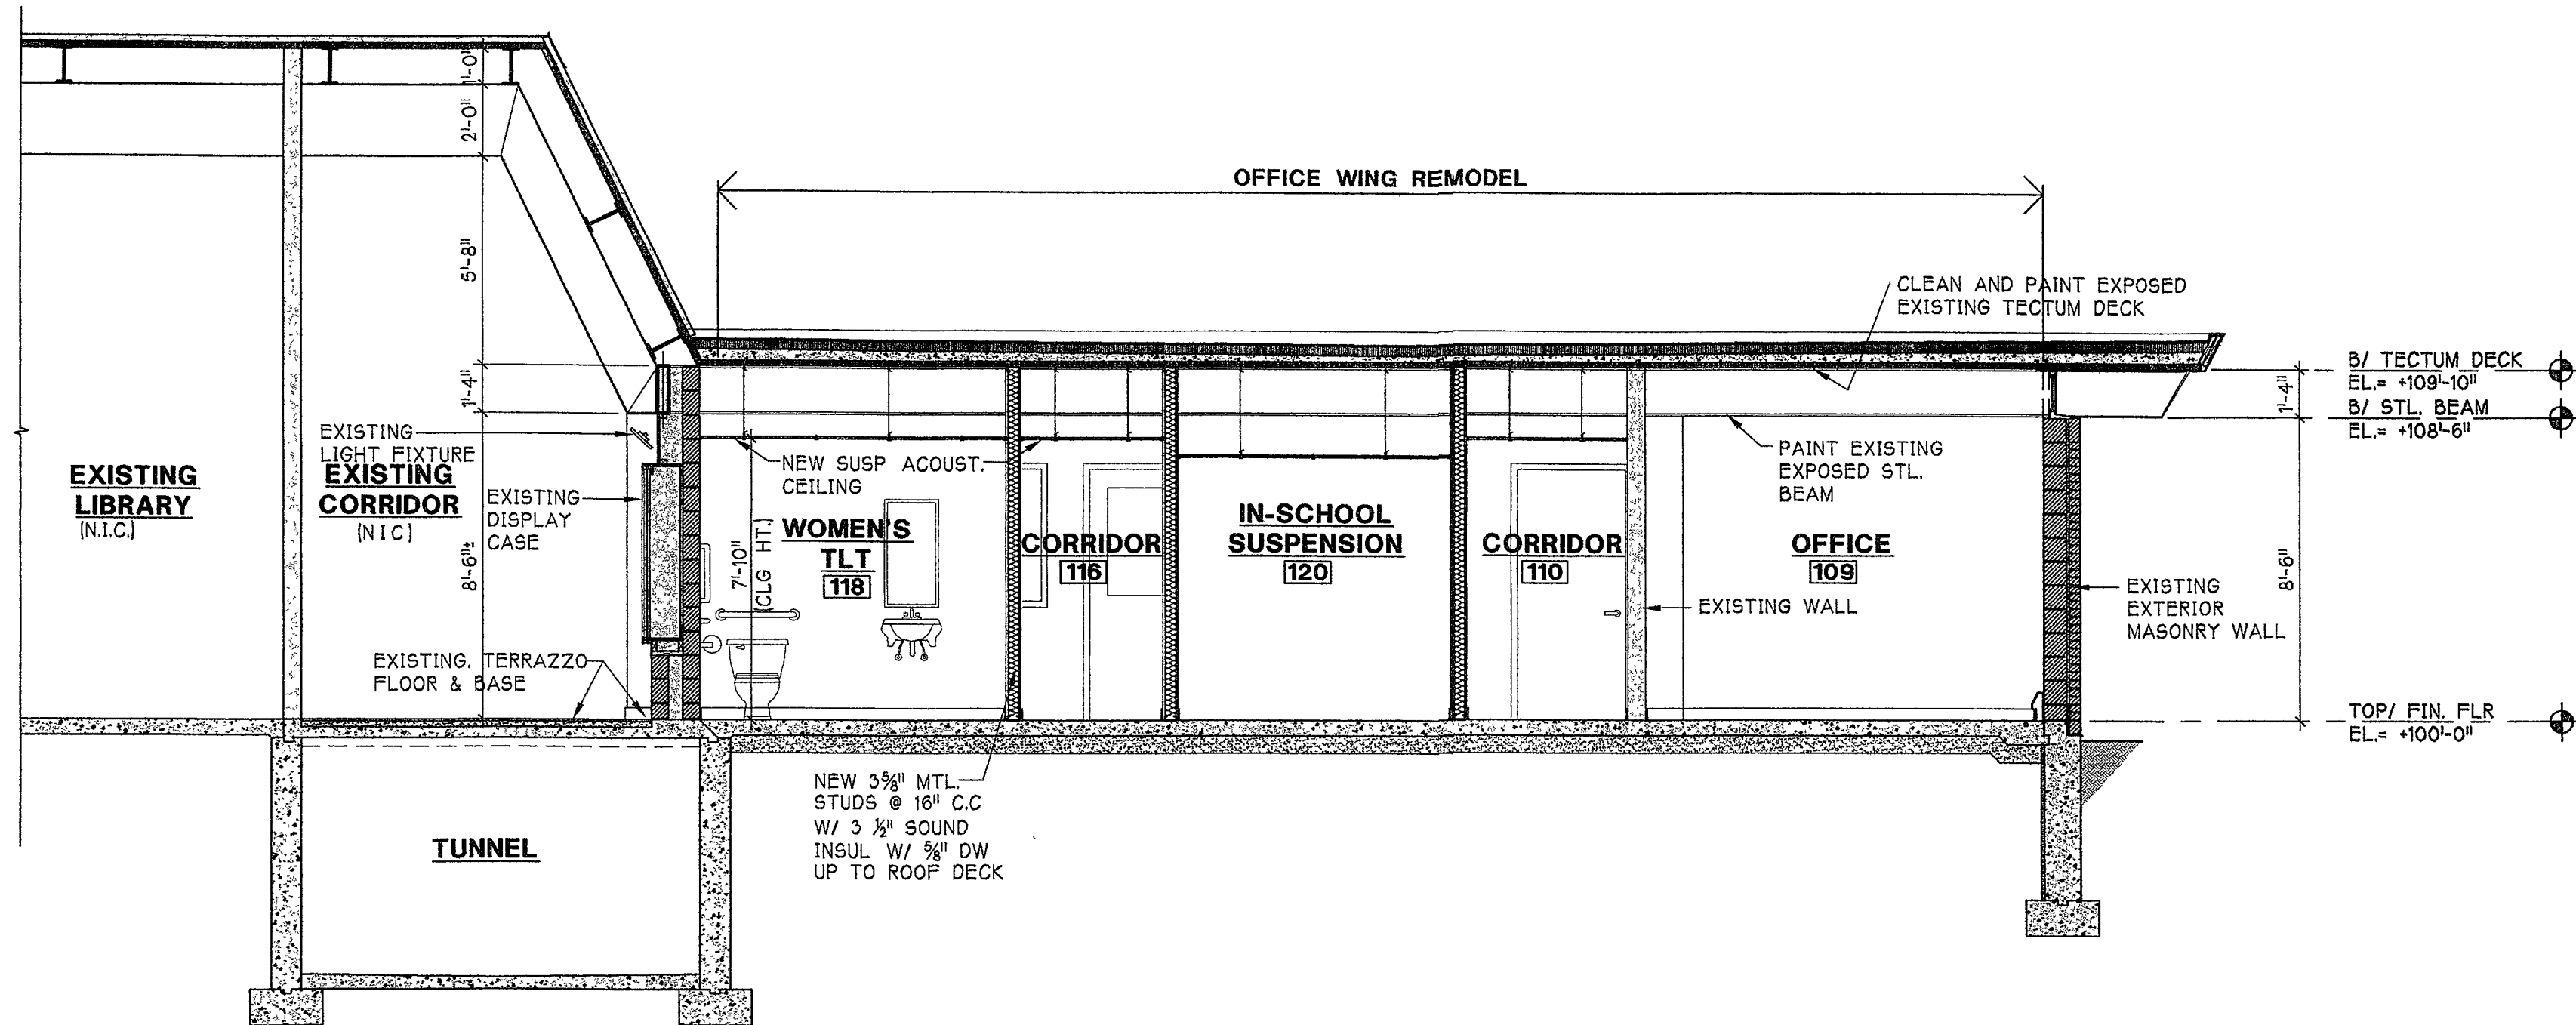


BUILDING SECTION 'A-A'

1/4" = 1'-0"

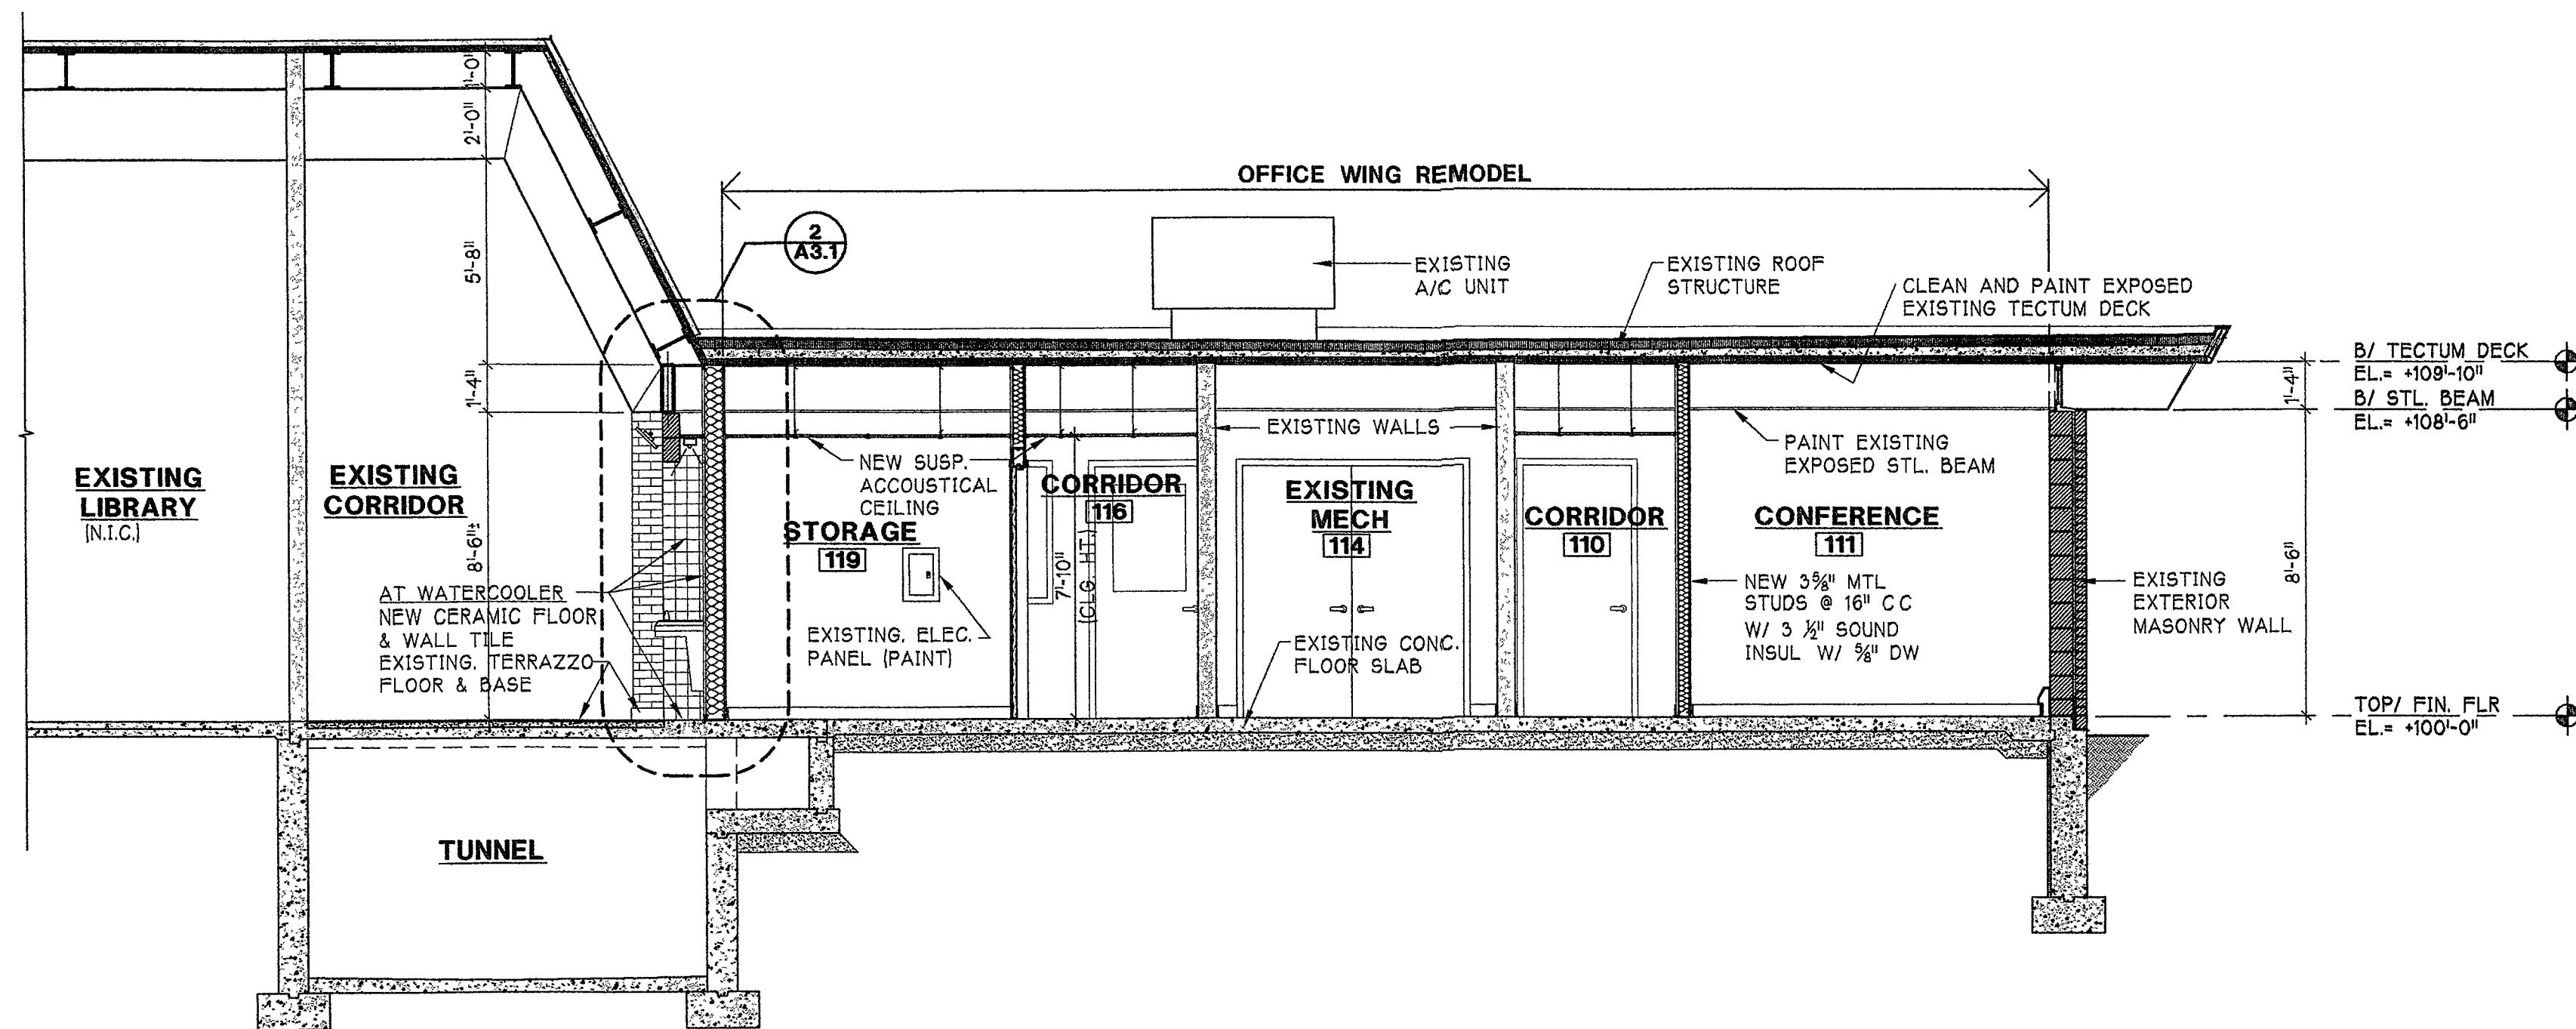


BUILDING SECTION 'B-B'

1/4" = 1'-0"

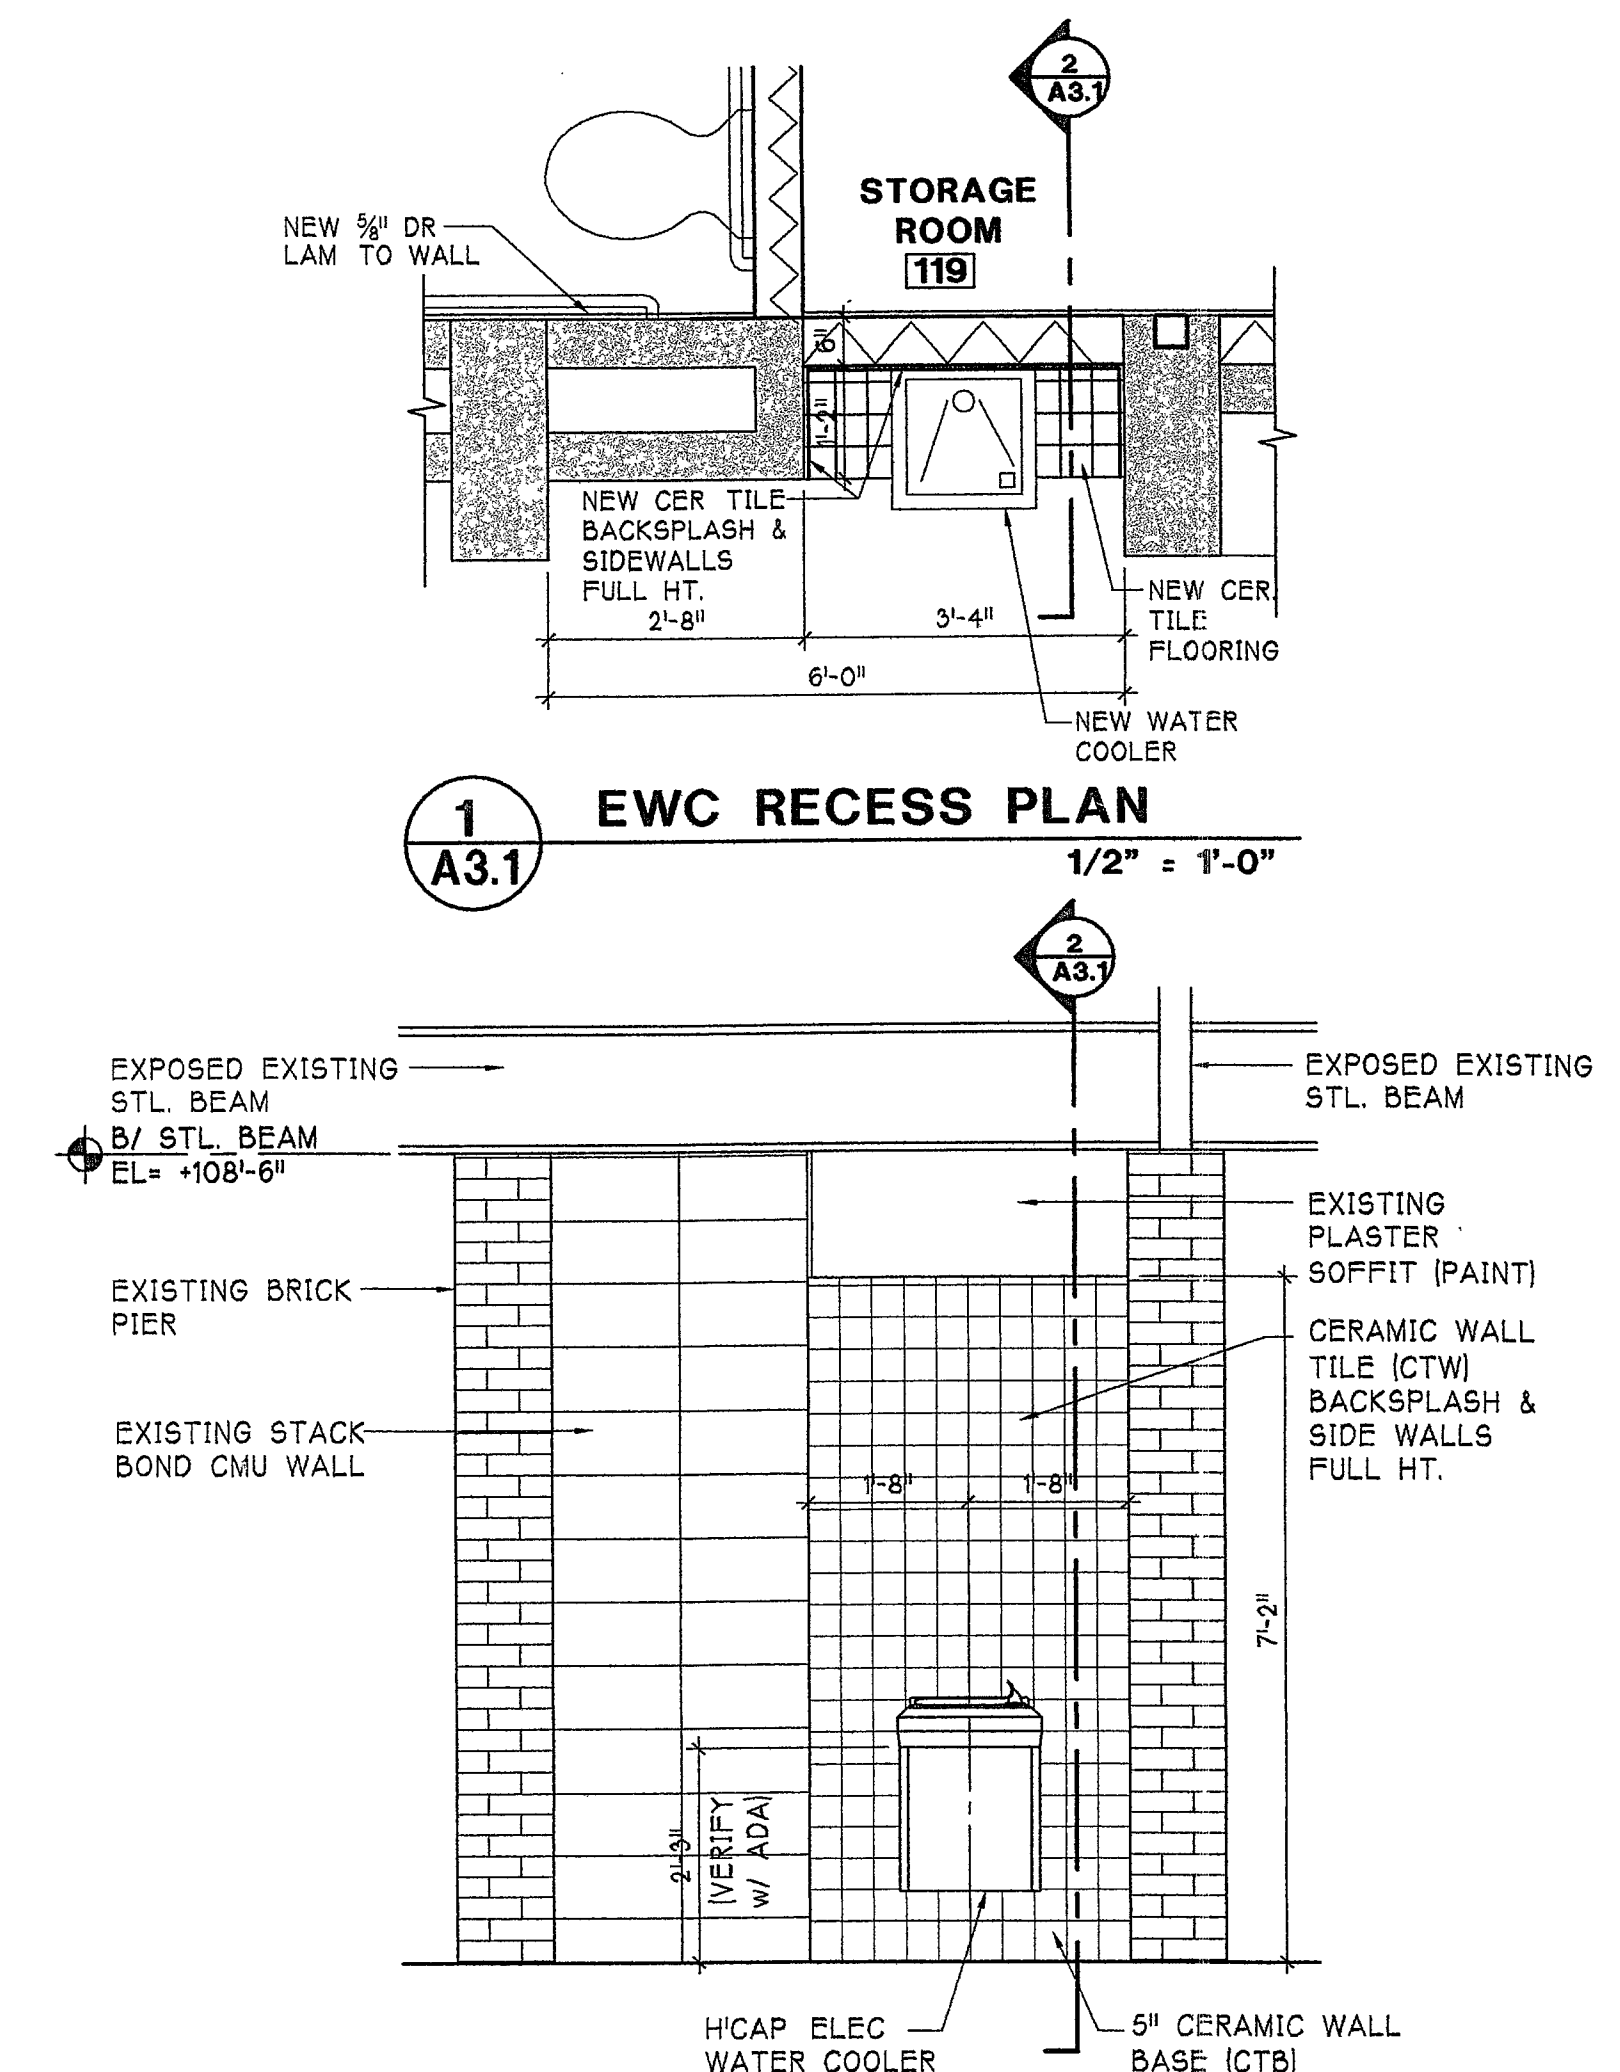

EWC ELEVATION

1/2" = 1'-0"

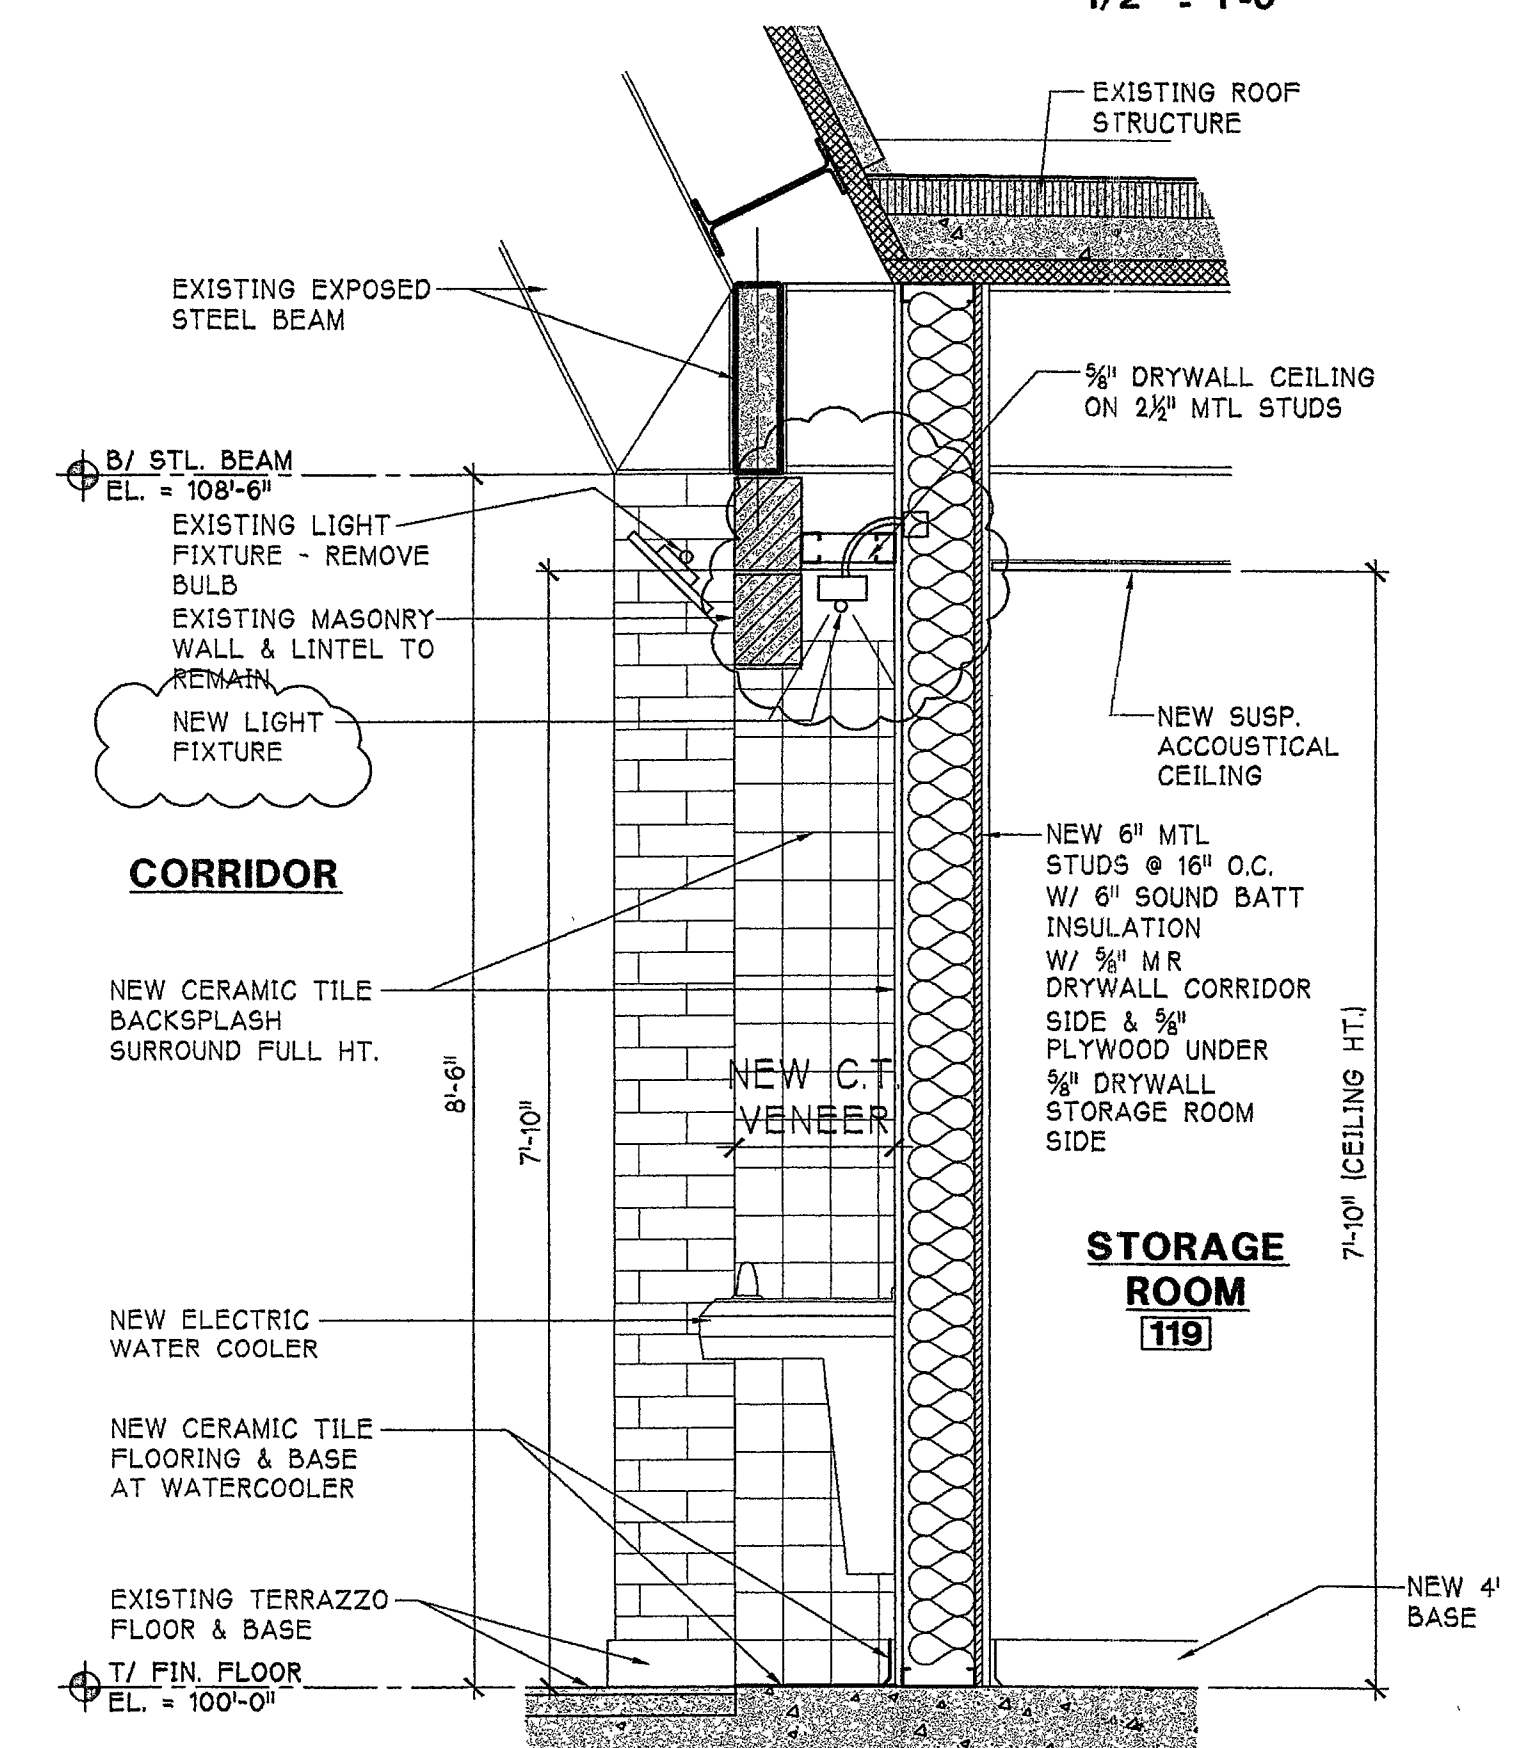

NEW WALL SECTION


@ WOMEN'S RM. 118 & CORRIDOR 3/4" = 1'-0"

REVISIONS BY



WESTCHESTER INTERMEDIATE SCHOOL - OFFICE REMODEL
CHESTER, INDIANA
gerometta & kinel architects, inc.

BUILDING SECTIONS
1050 S. FIFTH STREET
gerometta & kinel architects, inc.

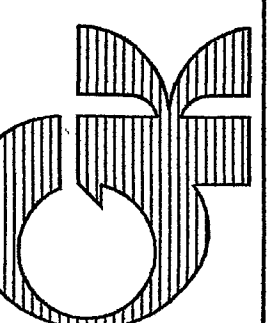

DATE 4/26/11
SCALE AS NOTED
DRAWN JAV
JOB 1117
SHEET

A3.1
OF 15 SHEETS