



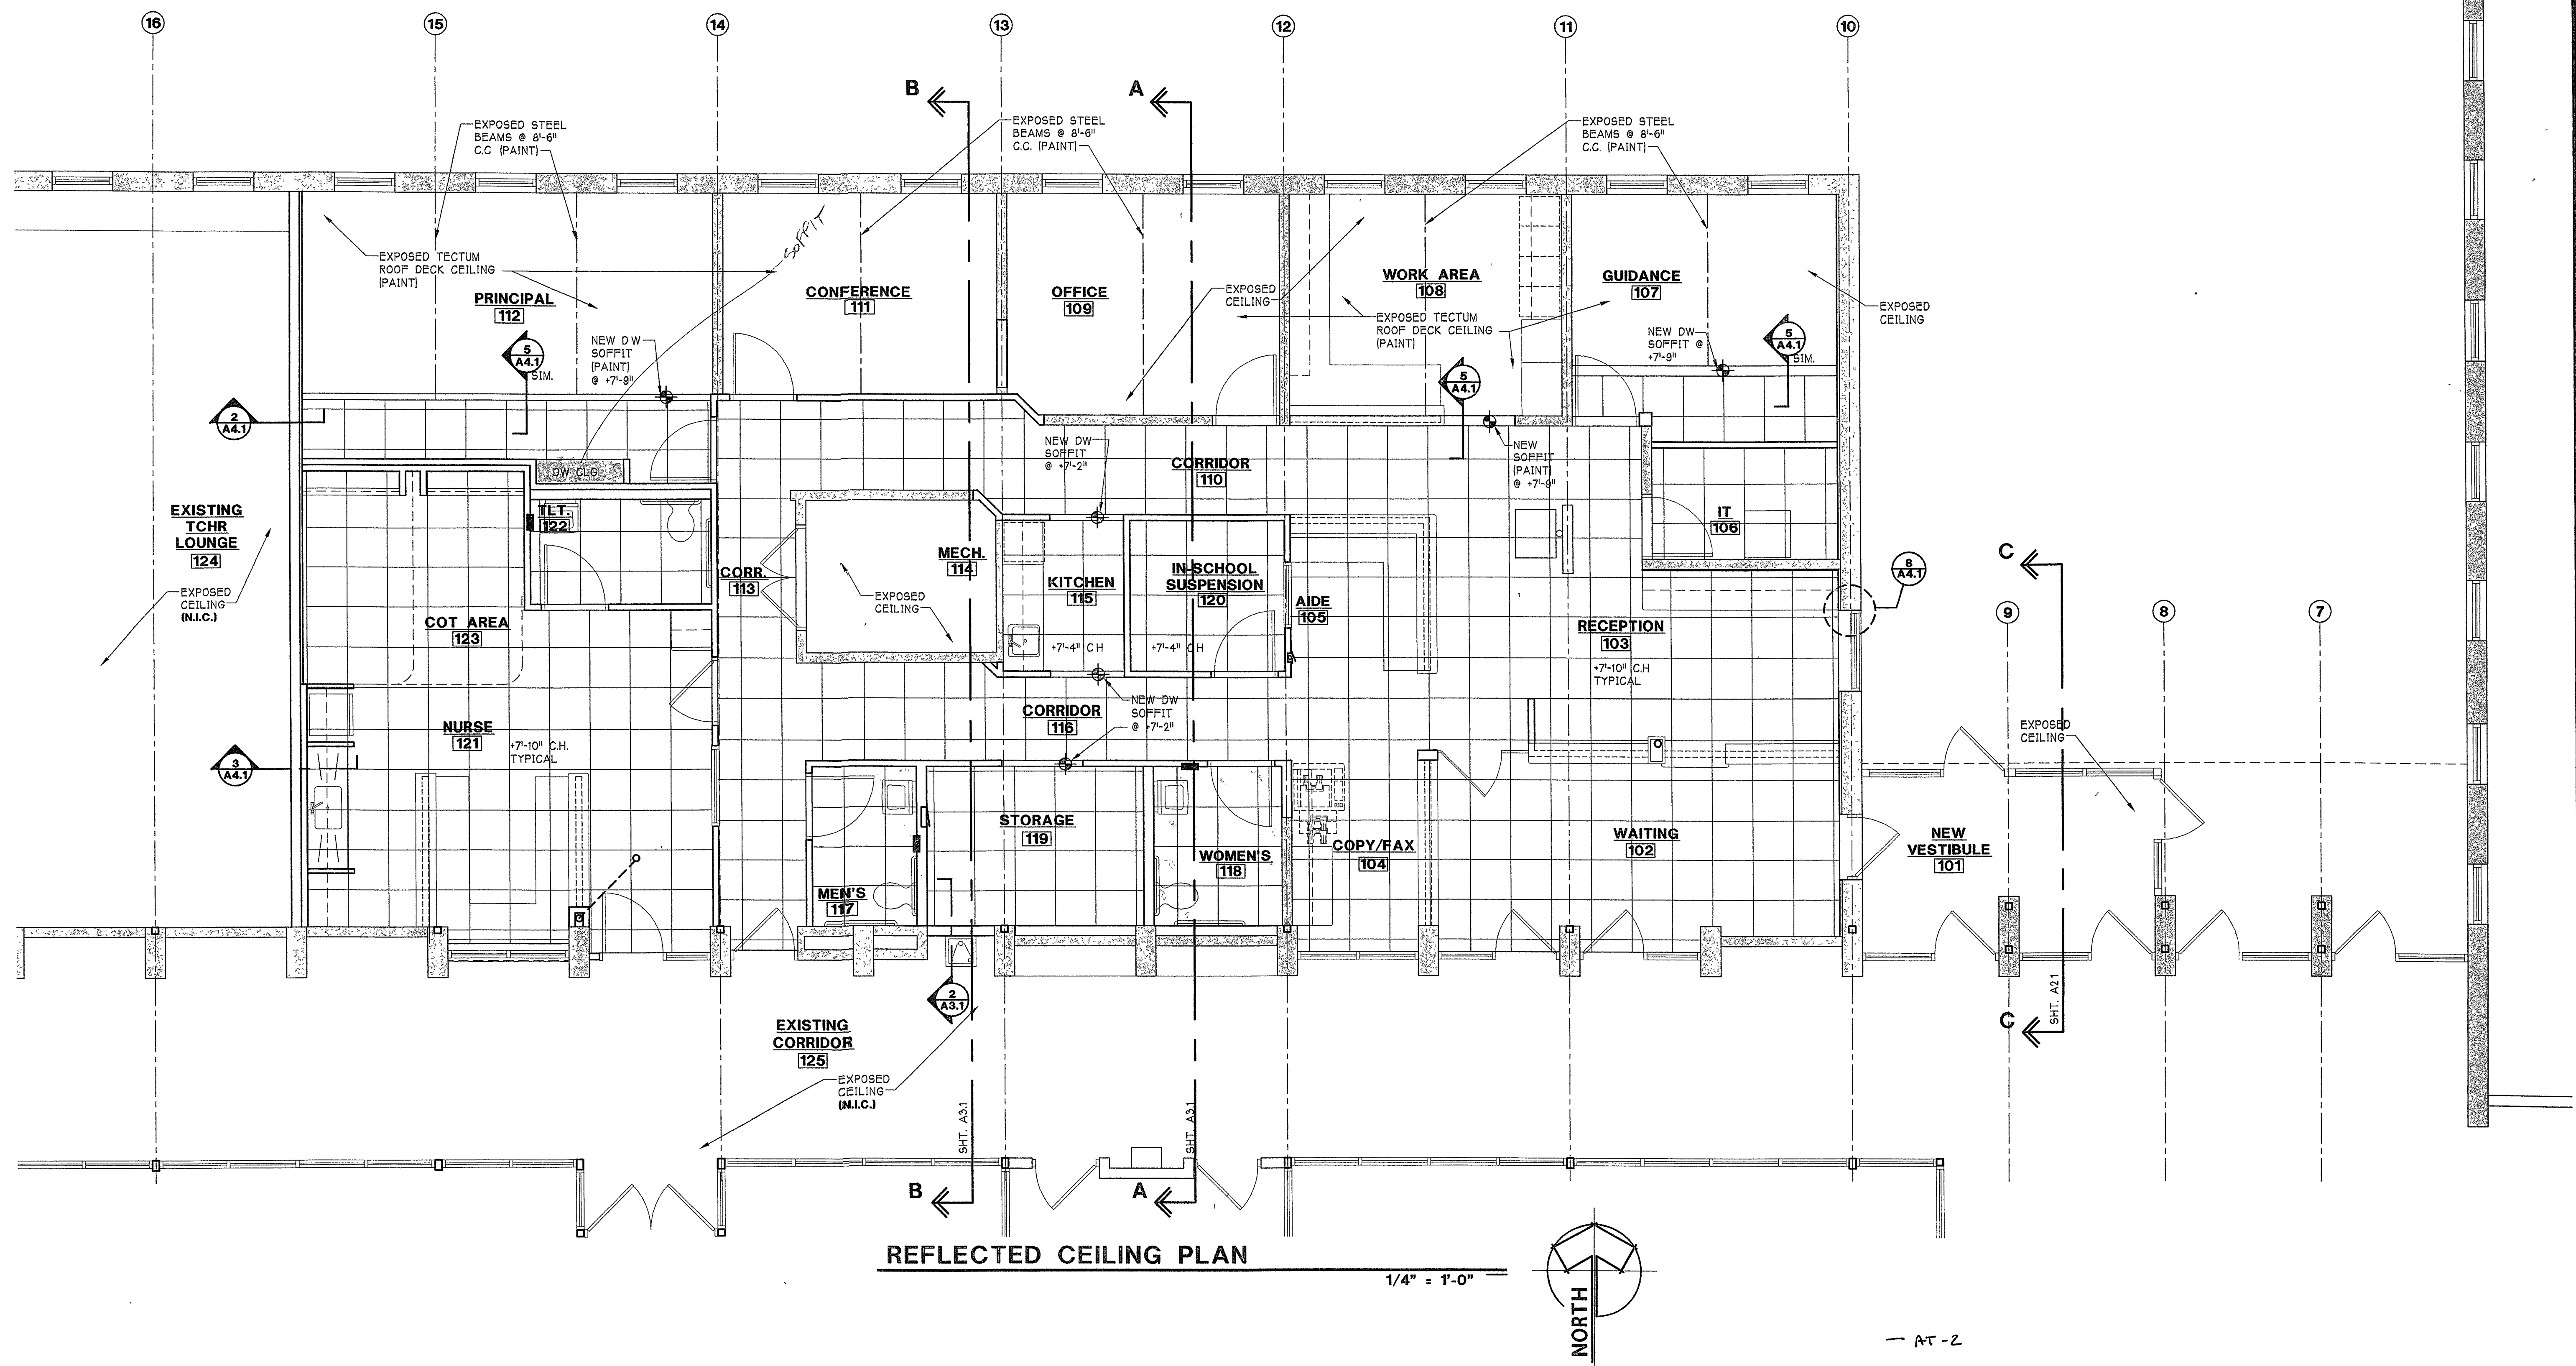


REFLECTED CEILING PLAN

1/4" = 1'-0"

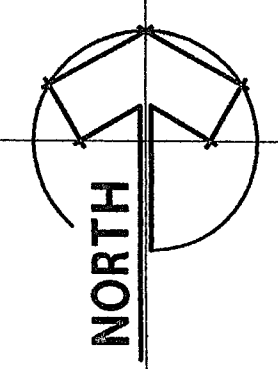


AT-2
ALL OTHER IS AT-1

REVISIONS	BY

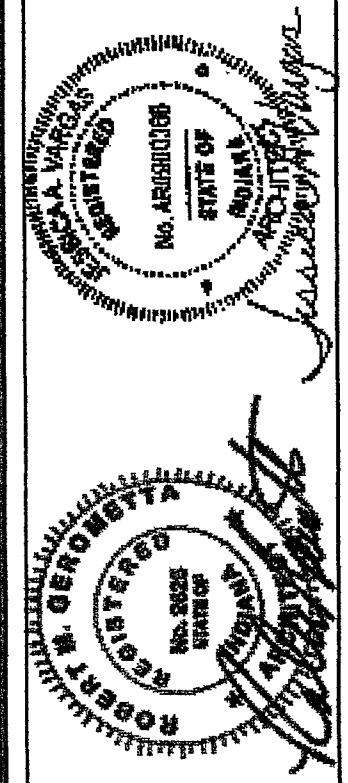

REFLECTED CEILING PLAN
WESTCHESTER INTERMEDIATE SCHOOL - OFFICE REMODEL
 CHESTERSTON, INDIANA
gerometta & kinel architects, inc.

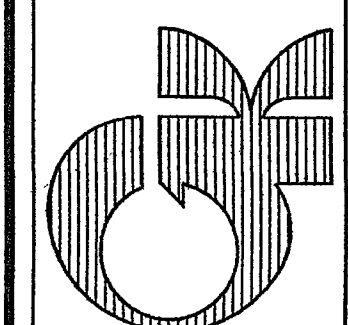

DATE	4/26/11
SCALE	AS NOTED
DRAWN	JAV
JOB	1117
SHEET	A6.1

OF 15 SHEETS