
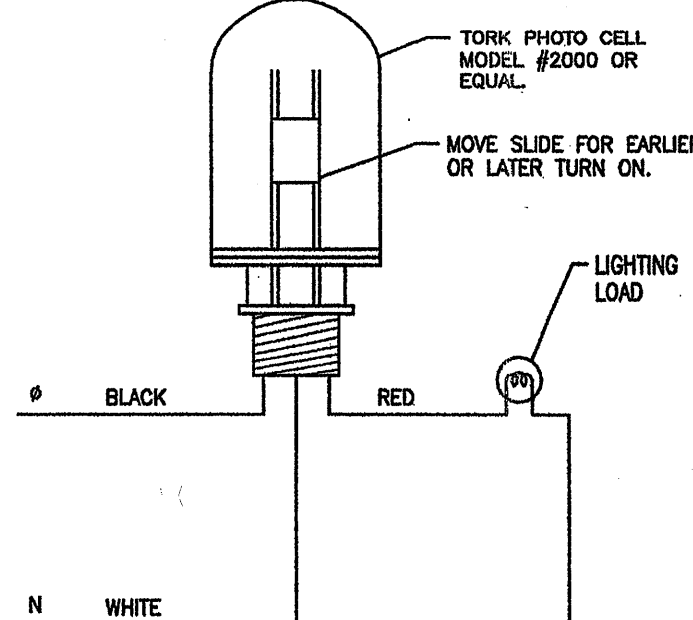



REVISIONS	BY

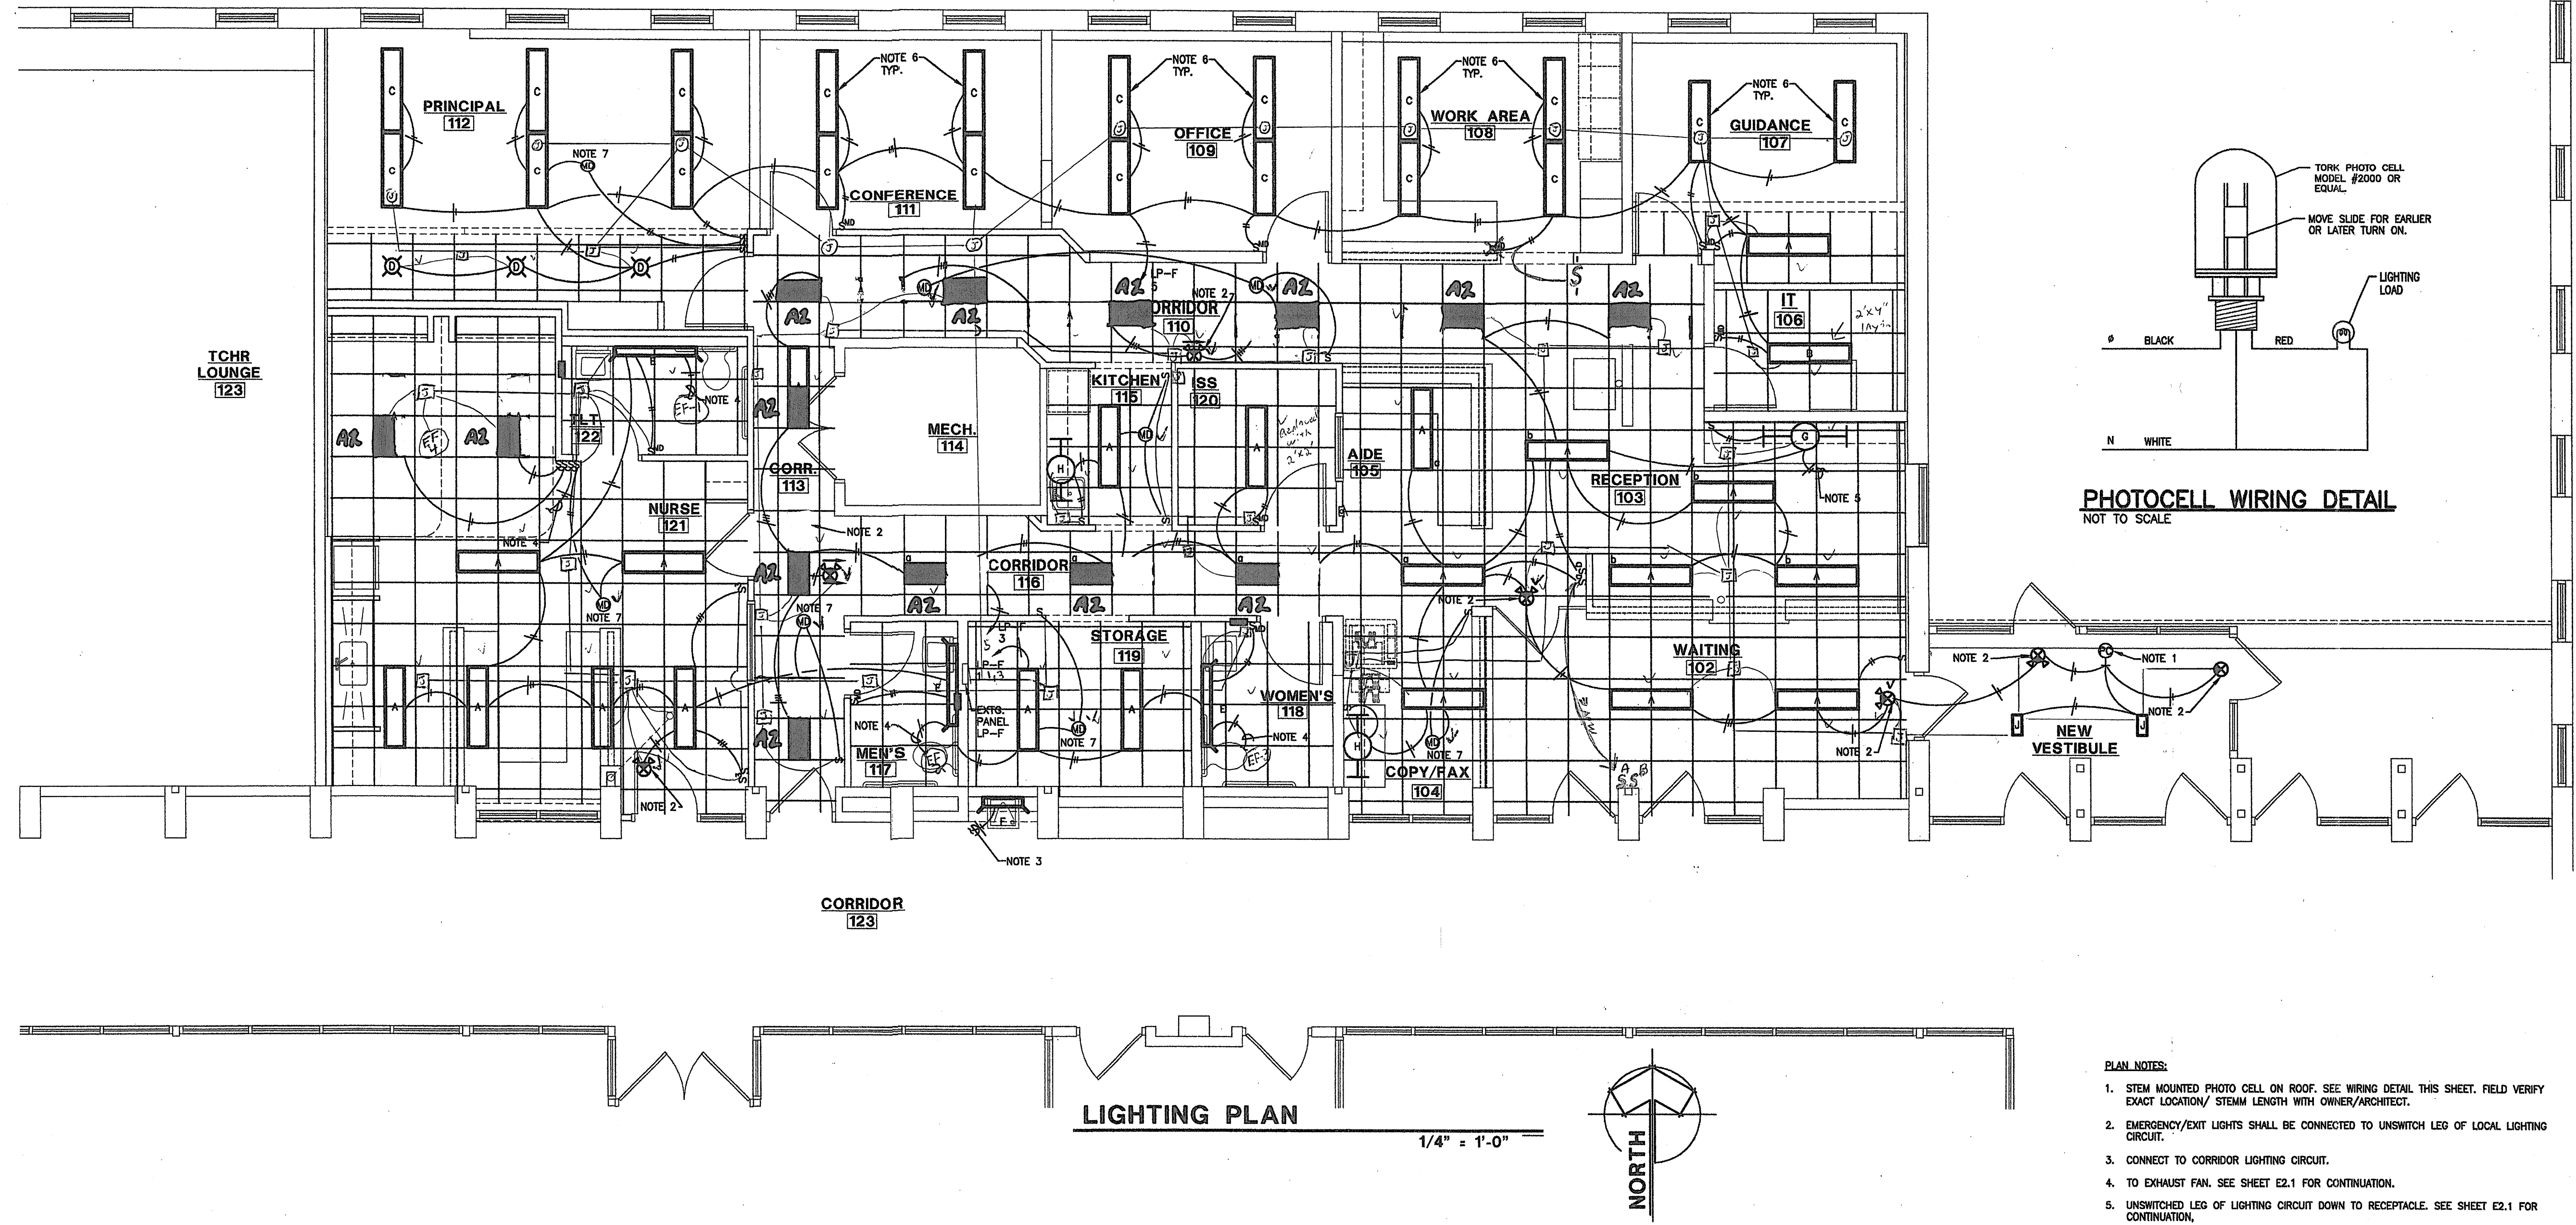


PHOTOCCELL WIRING DETAIL
NOT TO SCALE

- PLAN NOTES:
1. STEM MOUNTED PHOTO CELL ON ROOF. SEE WIRING DETAIL THIS SHEET. FIELD VERIFY EXACT LOCATION/ STEM LENGTH WITH OWNER/ARCHITECT.
 2. EMERGENCY/EXIT LIGHTS SHALL BE CONNECTED TO UNSWITCH LEG OF LOCAL LIGHTING CIRCUIT.
 3. CONNECT TO CORRIDOR LIGHTING CIRCUIT.
 4. TO EXHAUST FAN. SEE SHEET E2.1 FOR CONTINUATION.
 5. UNSWITCHED LEG OF LIGHTING CIRCUIT DOWN TO RECEPTACLE. SEE SHEET E2.1 FOR CONTINUATION.
 6. UTILIZE EXISTING RACEWAY FOR INSTALLATION OF NEW INDIRECT/DIRECT LIGHT FIXTURES. PROVIDE WHITE COVER PLATES FOR UNUSED OPEN J-BOXES. COORDINATE WITH EXISTING FIELD CONDITIONS AS REQUIRED.
 7. LOW VOLTAGE MOTION DETECTORS TO BE WIRED TO ALLOW FOR OVER RIDE BY WALL SWITCH. WIRE PER MANUFACTURER'S REQUIREMENTS. PROVIDE COMPLETE WITH TRANSFORMER AND ALL REQUIRED EQUIPMENT FOR PROPER OPERATION.

LIGHTING PLAN
WESTCHESTER INTERMEDIATE SCHOOL - OFFICE REMODEL
1050 S. FIFTH STREET
gerometta & kinel architects, inc.
CHESTERTON, INDIANA
chesterton, Indiana

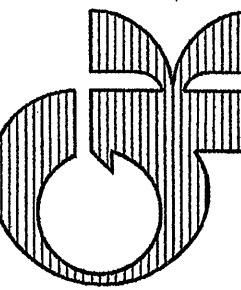

DATE	4/26/11
SCALE	AS NOTED
DRAWN	THH, MCT
JOB	1117
SHEET	E3.1
OF	15 SHEETS

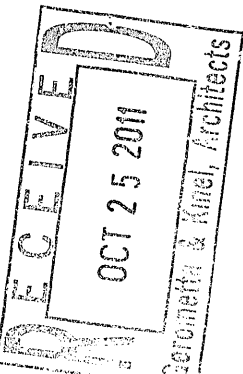

11-5-04