


Yost
Door
Plans

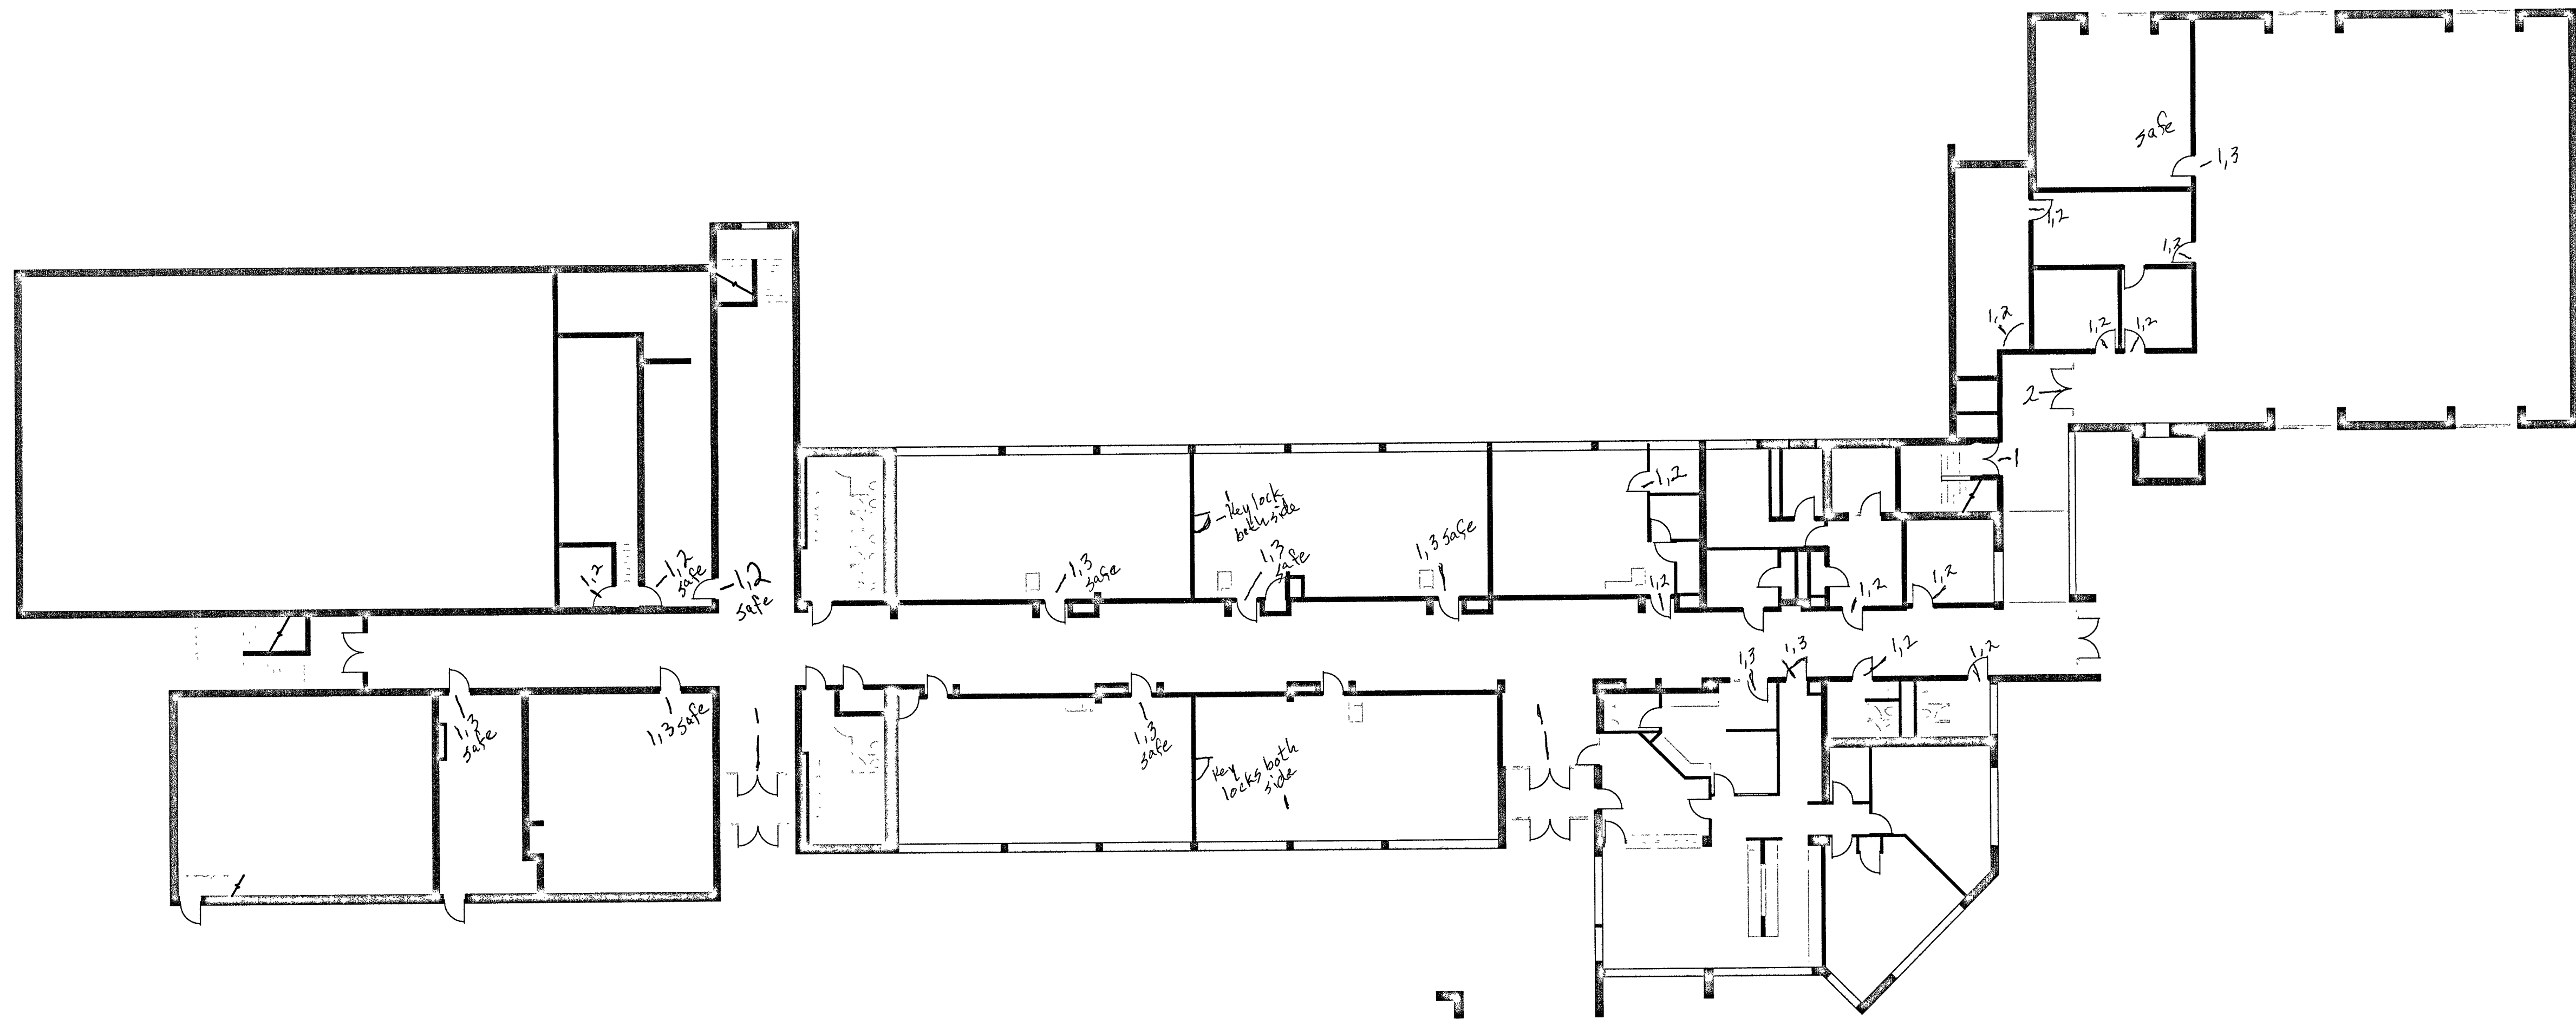

1 SECOND FLOOR PLAN
1/16" = 1'-0"



Yost Plan Key (fl. 2)

- 6. New door & hardware
- 7. New Cylindrical Hardware
- 8. New Mortise Hardware
- 9. Owner will change 1 exist core
Remaining hardware/installation responsibility of contractor
- 10. Exit Only

Doors not labeled will be left "as is"

PROJECT NUMBER	REVISIONS
10-00	
PROJECT MANAGER	DATE
DESIGNER	DATE
ISSUED FOR REVIEW	DATE
SECOND FLOOR PLAN	

