



100 W Beam St
100 W Beam St

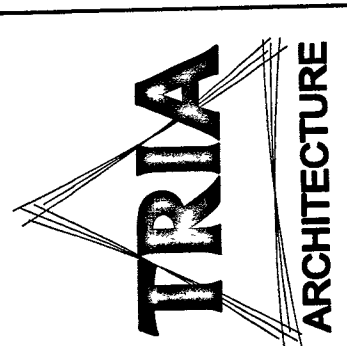


DUNELAND SCHOOL CORPORATION
2016
YOST ELEMENTARY SCHOOL
100 W. BEAM ST. CHESTERTON, IN 46304

PROJECT NUMBER	100
PROJECT NAME	YOST

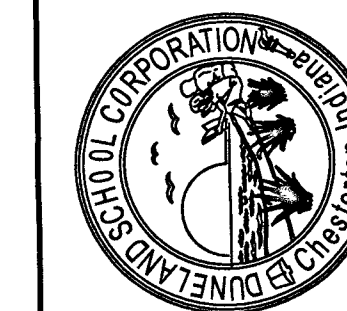

A1.0

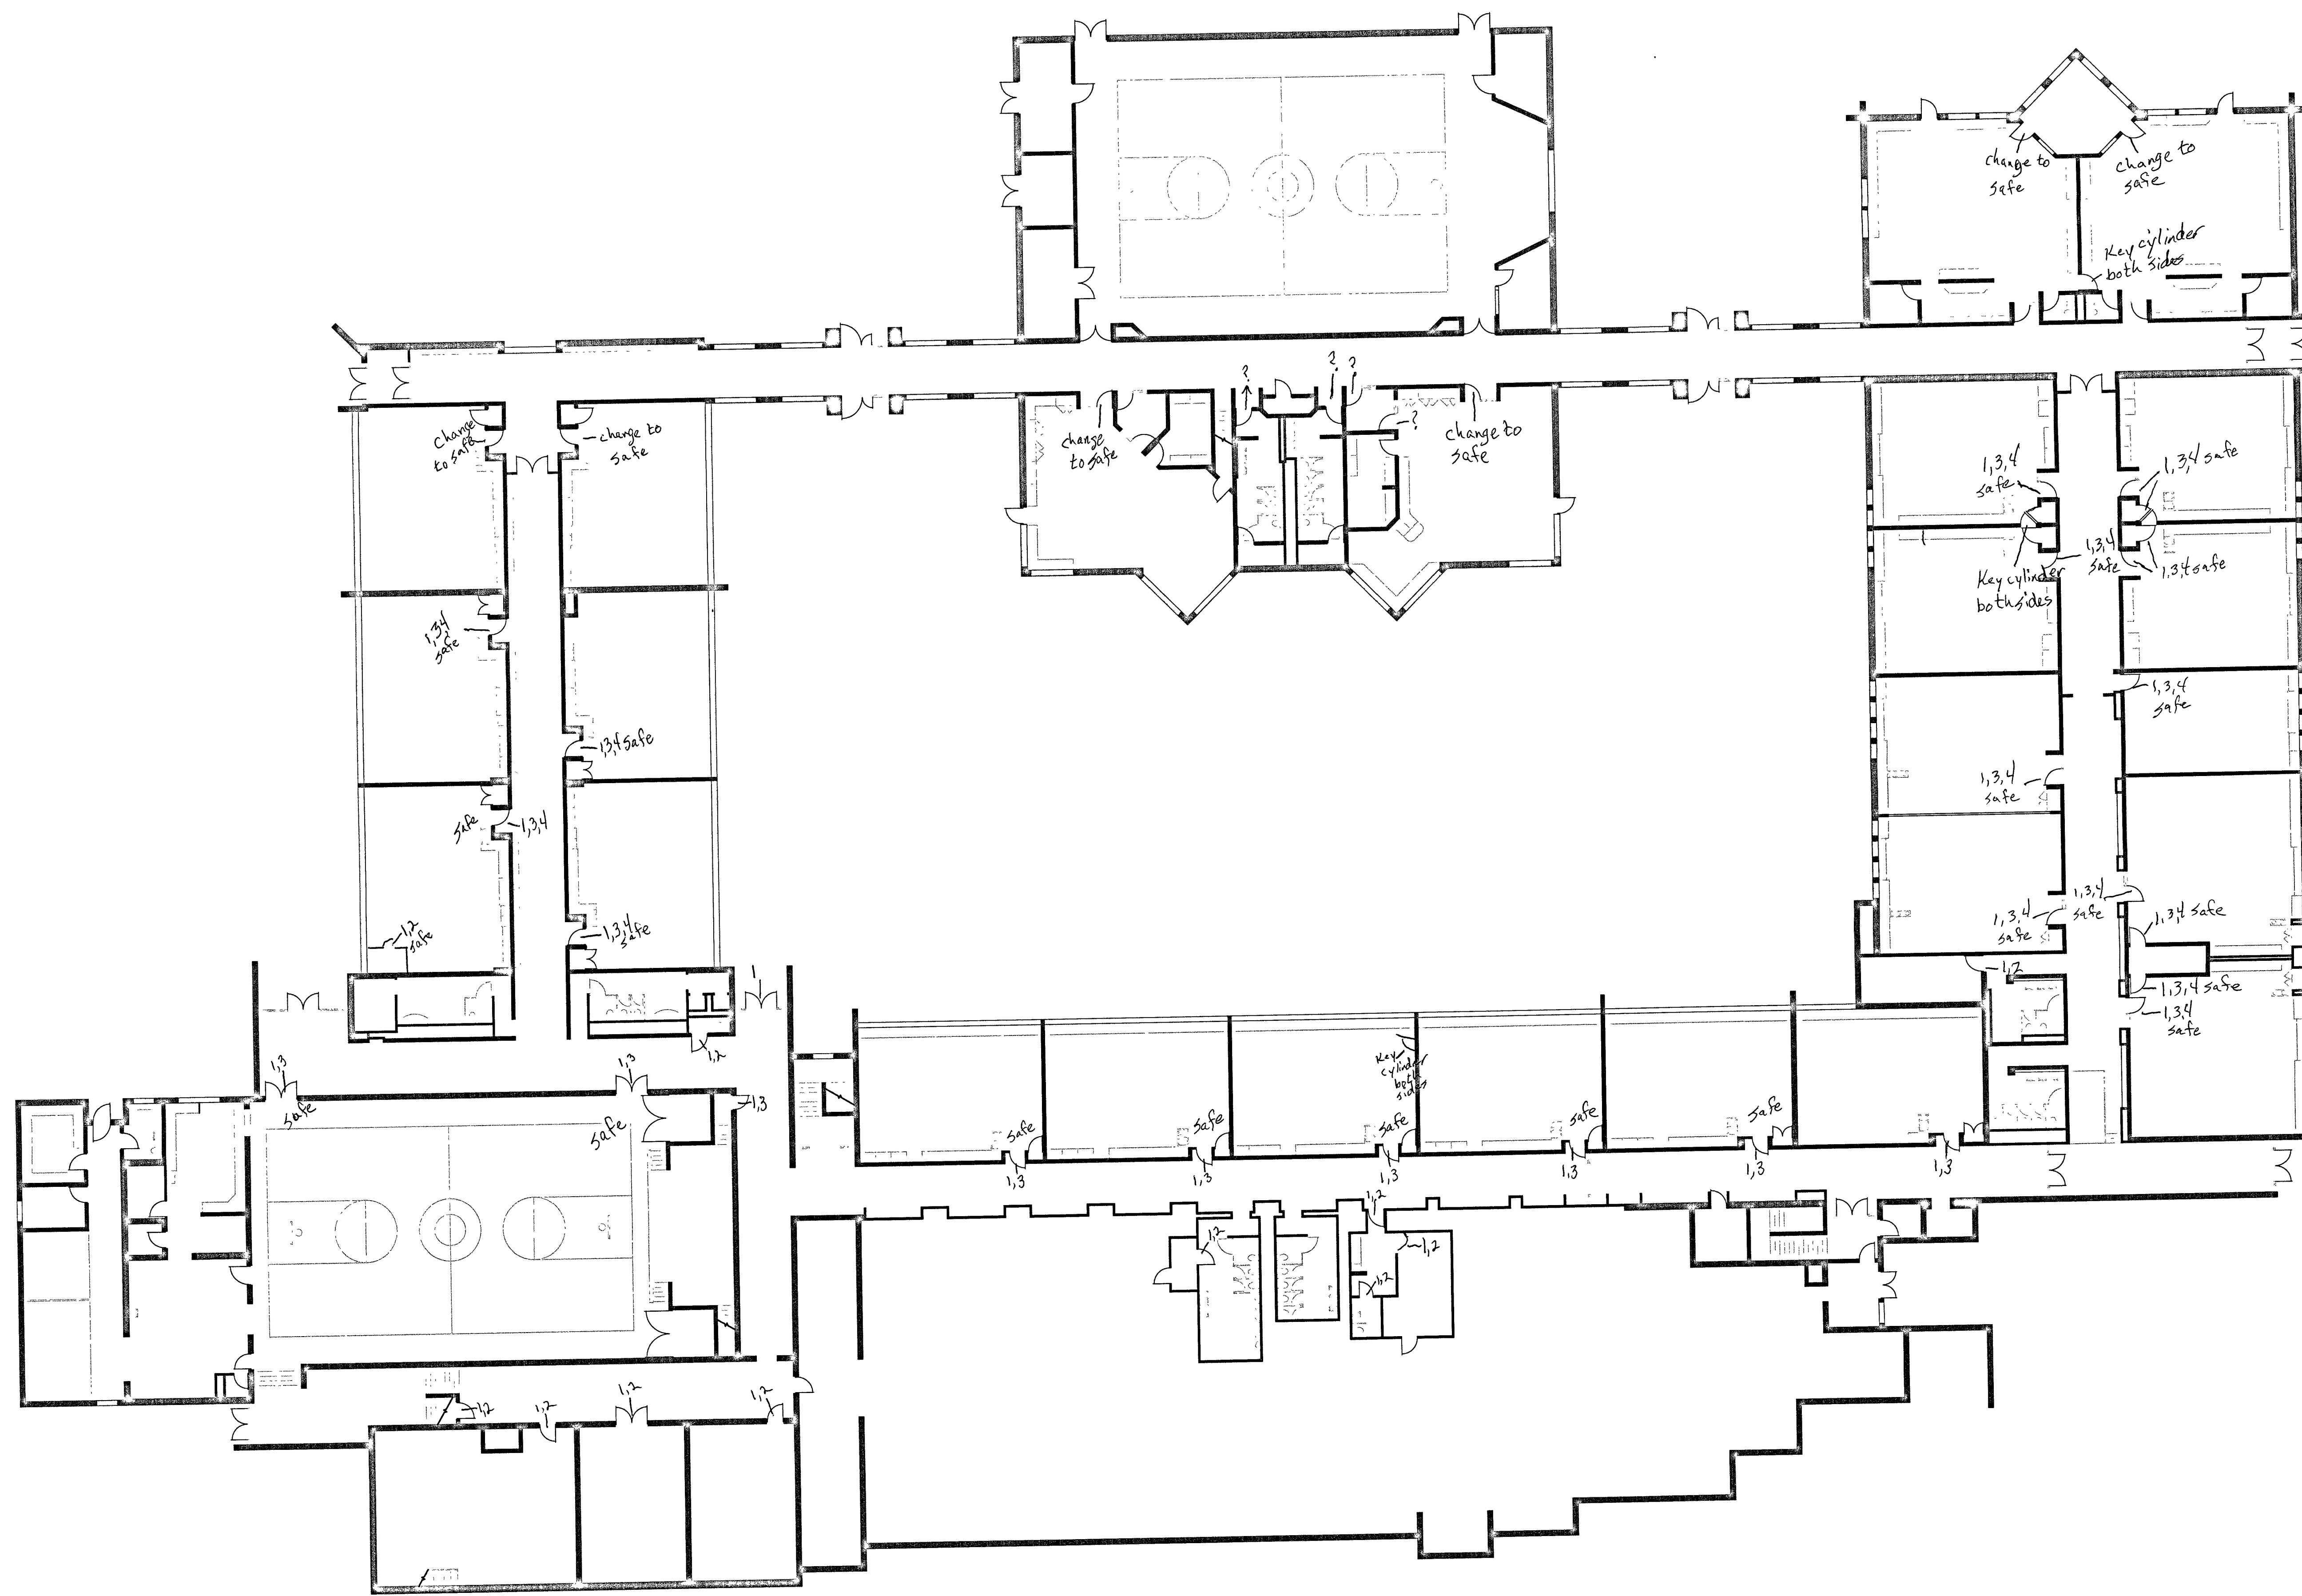

1 FIRST FLOOR PLAN
1/8" = 1'-0"

- Yost Plan Key (fl. 1)
1. New door & hardware
 2. New Cylindrical Hardware
 3. New Mortise Hardware
 4. Owner will change 1 exist core
Remaining hardware/installation responsibility of contractor
 5. Exit Only
- Doors not labeled will be left "as is"