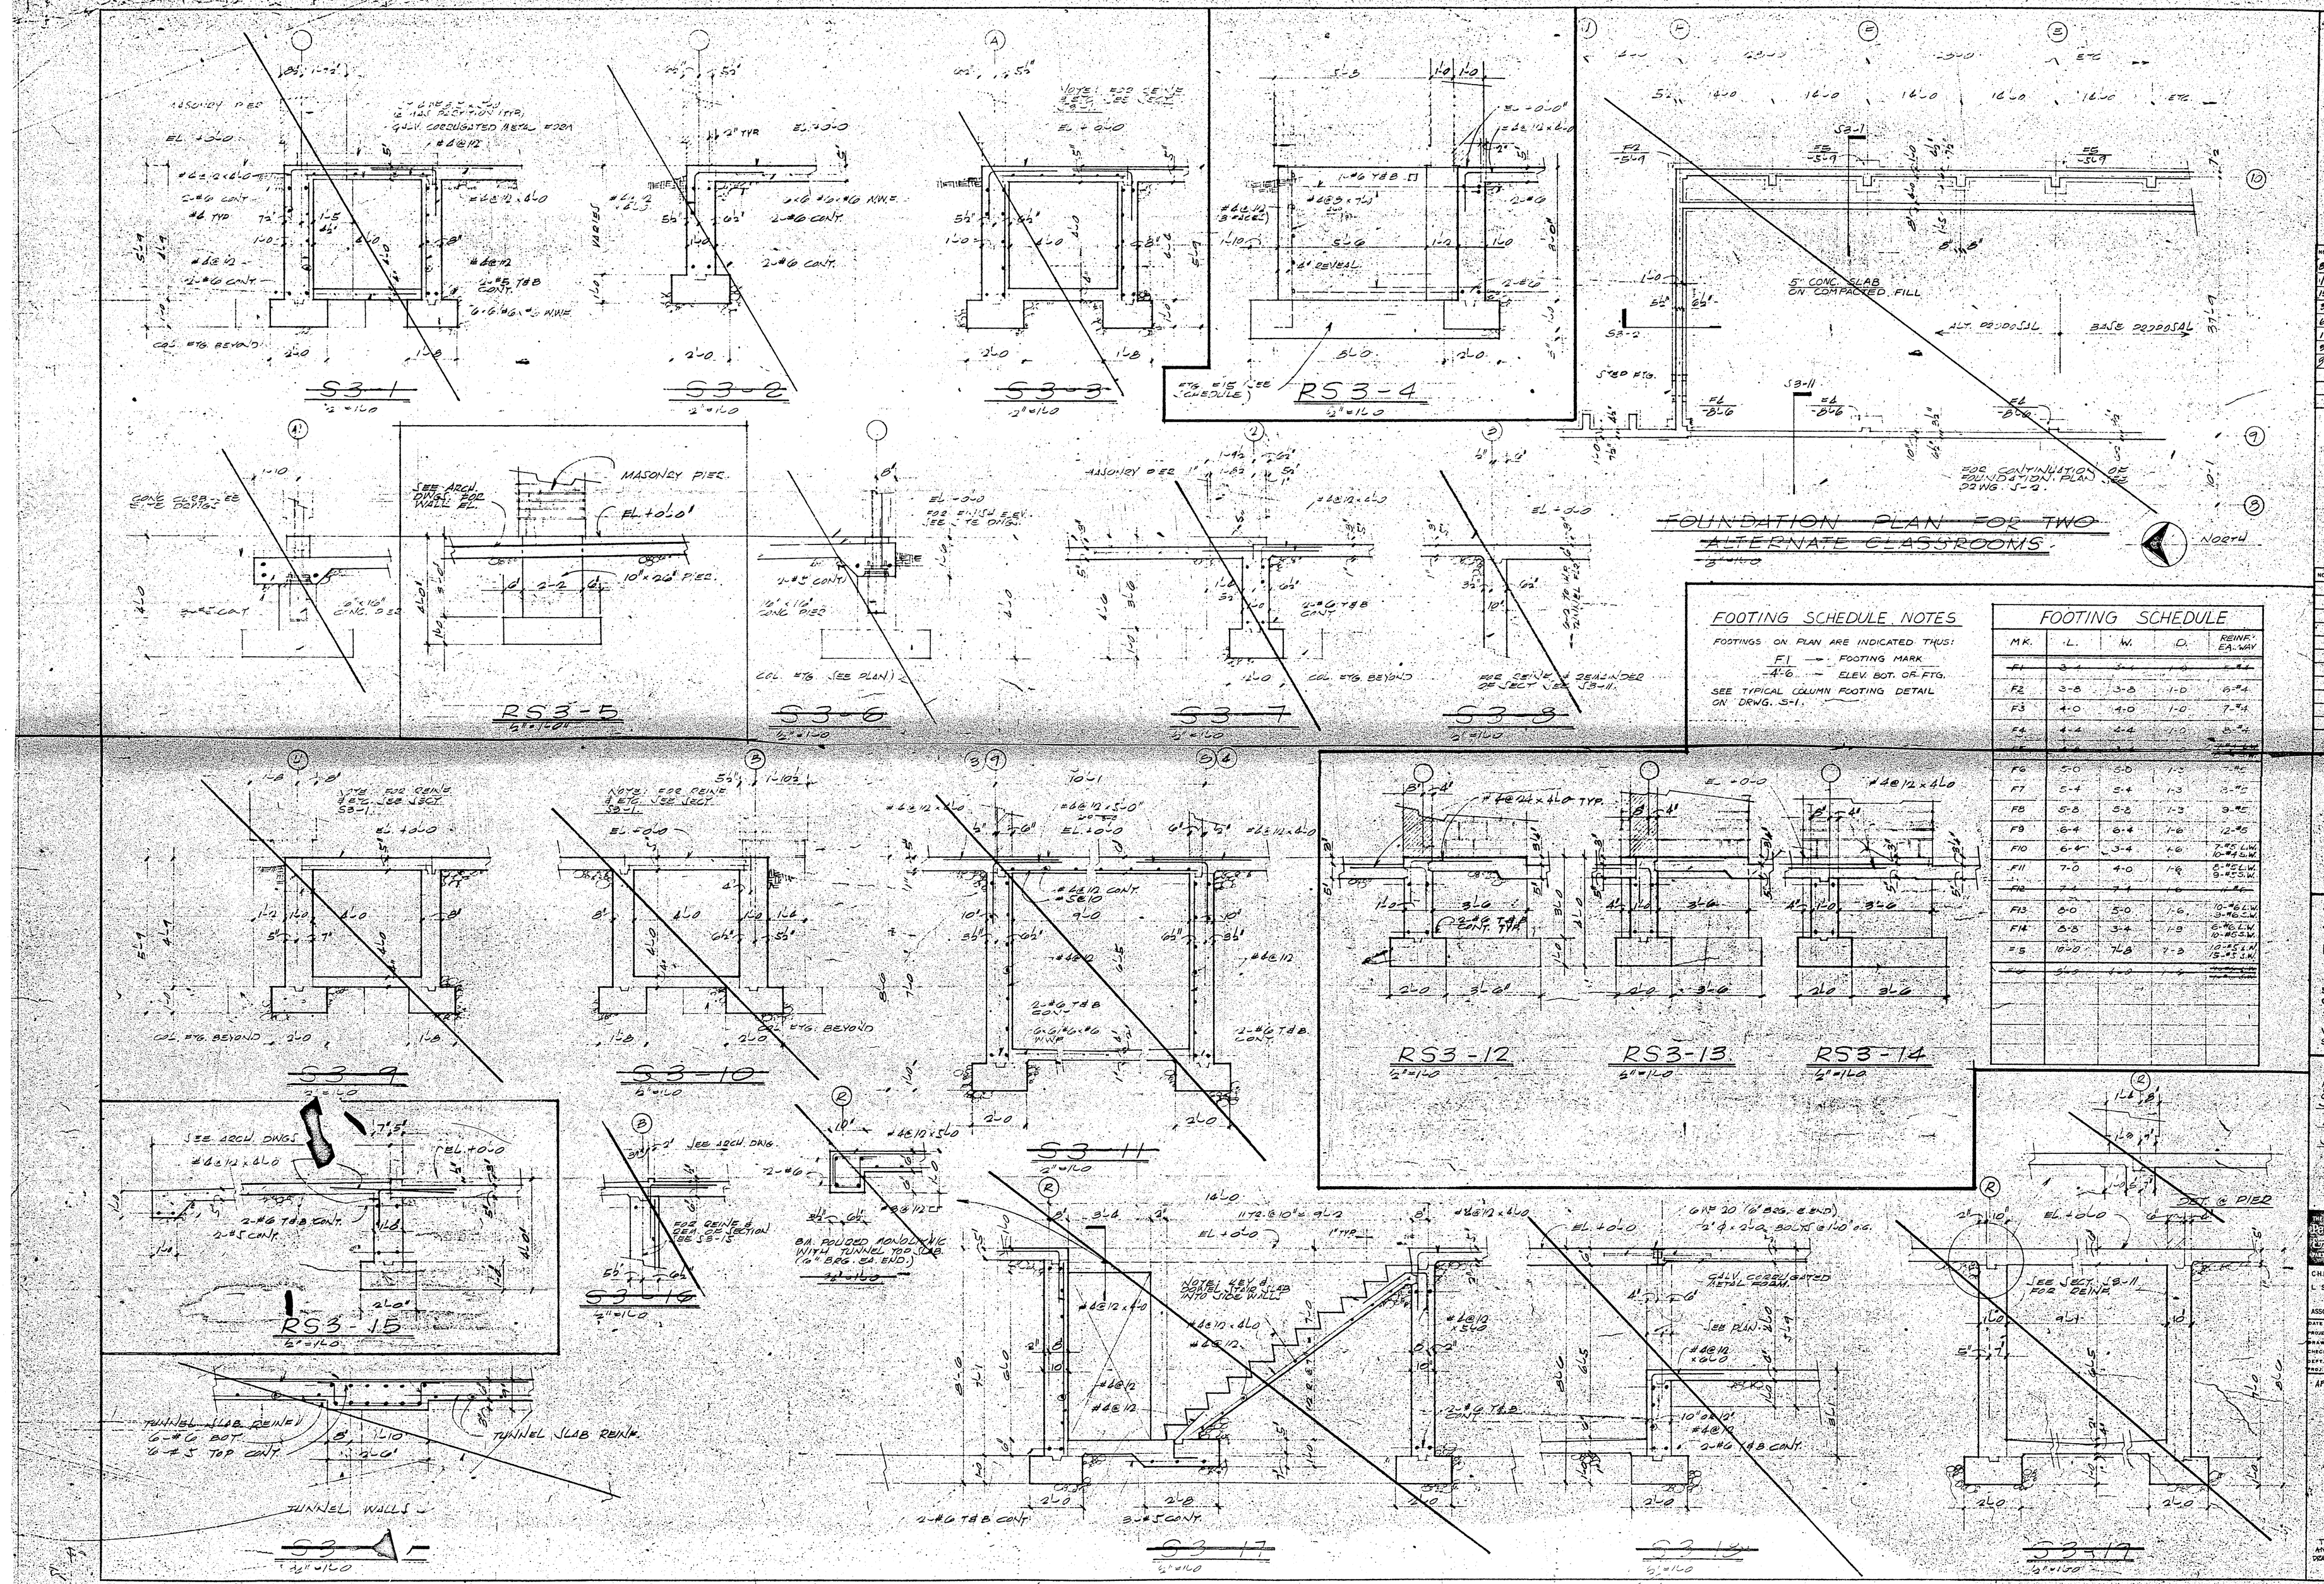

FOOTING SCHEDULE NOTES

FOOTINGS ON PLAN ARE INDICATED THUS:

F1 — FOOTING MARK
-4'-6 — ELEV. BOT. OF FTG.

SEE TYPICAL COLUMN FOOTING DETAIL ON DRWG. S-1.

FOOTING SCHEDULE

MK.	L.	W.	D.	REINF. EA. WAY
~~F1~~	~~3-4~~	~~3-4~~	~~1-0~~	~~#4~~
F2	3-8	3-8	1-0	6-#4
F3	4-0	4-0	1-0	7-#4
F4	4-4	4-4	1-0	8-#4
~~F5~~	~~4-8~~	~~4-8~~	~~1-0~~	~~9-#4~~
F6	5-0	5-0	1-3	#5
F7	5-4	5-4	1-3	3-#5
F8	5-8	5-8	1-3	3-#5
F9	6-4	6-4	1-6	2-#5
F10	6-4	3-4	1-6	7-#5 L.W. 10-#5 S.W.
F11	7-0	4-0	1-9	8-#5 L.W. 9-#5 S.W.
~~F12~~	~~7-4~~	~~7-4~~	~~1-6~~	~~#6~~
F13	8-0	5-0	1-9	10-#5 L.W. 3-#5 S.W.
F14	8-8	3-4	1-9	6-#5 L.W. 10-#5 S.W.
~~F15~~	~~10-0~~	~~7-8~~	~~1-3~~	~~10-#5 L.W. 15-#5 S.W.~~
~~F16~~	~~5-0~~	~~1-0~~	~~1-6~~	~~#6~~

NO.	PRINTS & DISTRIBUTION	BY	DATE
8	OFFICE (3) G.C. (5)	JJC	9-26-66
7	SCHOOL DISTRICT	JJC	10-13-66
15	G.C. (4) OFFICE (1)	JJC	8-24-66
5	OFFICE (1) STRUPP (1)	JJC	8-24-66
6	VAN KEPPEL (GCC)	JJC	8-31-66
1	THYSSEN	JJC	1-28-66
3	SCHOOL BOARD (1) BOND (1)	JJC	2-4-66
8	SCHOOL (1) INFO. (1)	WEAM	7-1-66

NO.	REVISIONS THUS	BY	DATE

WESTCHESTER TOWNSHIP ELEMENTARY SCHOOL

5th STREET & UNION AVENUE
CHESTERTON INDIANA

FOR THE
WESTCHESTER TOWNSHIP SCHOOL CORPORATION

FOUNDATION SECTIONS, FOOTING SCHEDULE

ARCHITECTS
Dorwin & Will Associates
309 West Jackson Blvd.
Chicago, Illinois 60606
Phone 312-922-9300

CHESTER L. STEMP & ASSOCIATE ENGINEERS
132 North Calumet Ave.
Chesterton, Indiana 46304
Phone 219-926-5190

DATE 8-26-66
PROJECT NO. 21970-3
DRAWN BY COHEN
CHECKED BY RITTS
DEPT. HEAD COZZI
PROJ. ARCH. R. BENQUIST

APPROVED FOR CONSTRUCTION SEPTEMBER 29, 1966

RS 3

THIS DRAWING SUPERSEDES AND REPLACES DRAWING # S-3 DATED 6-21-66