
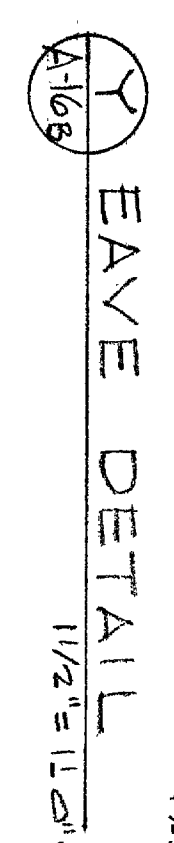
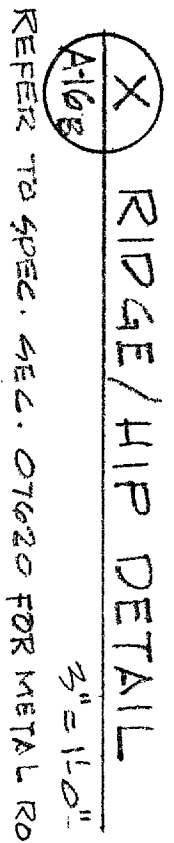
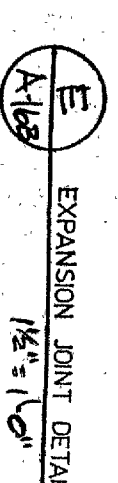
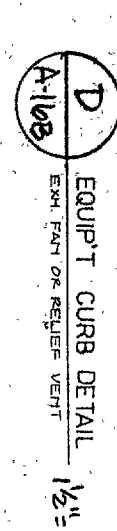




REVISIONS BY

	REVISIONS
	BY

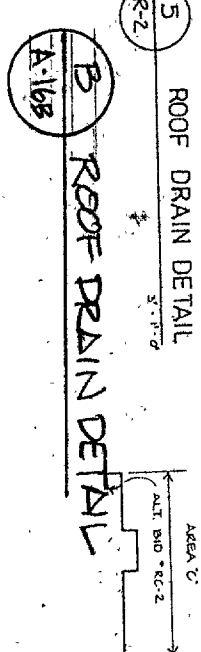



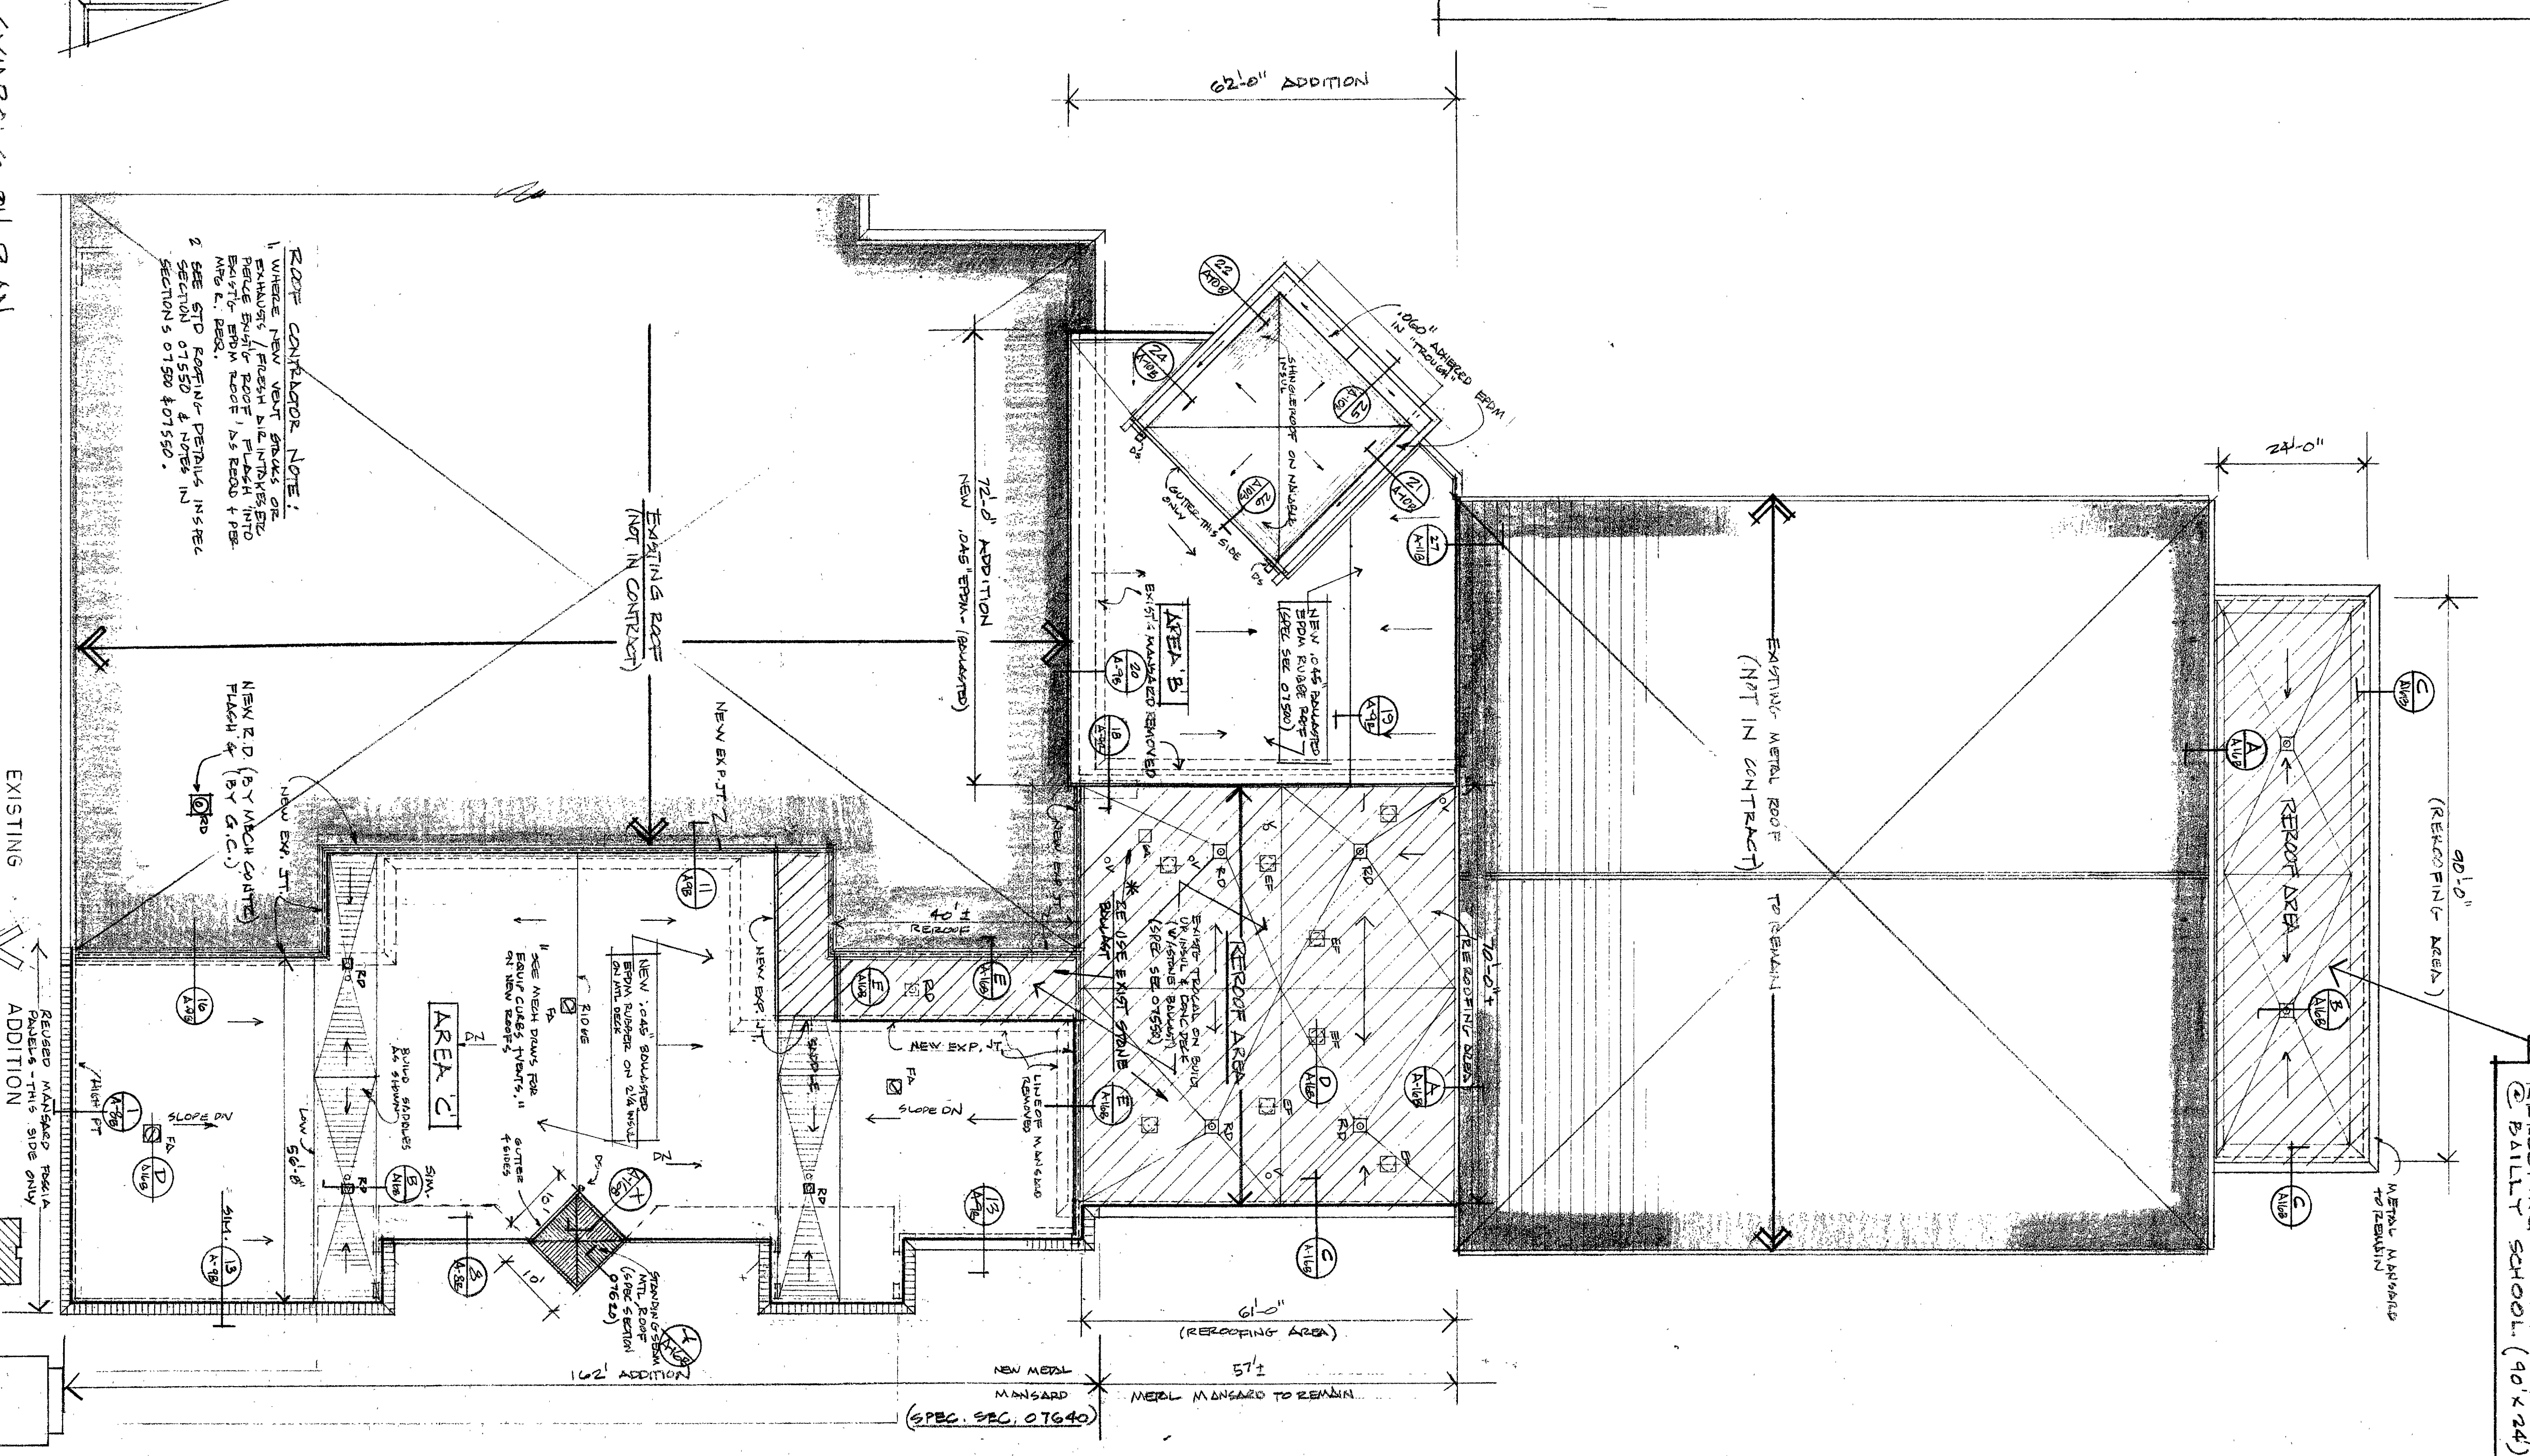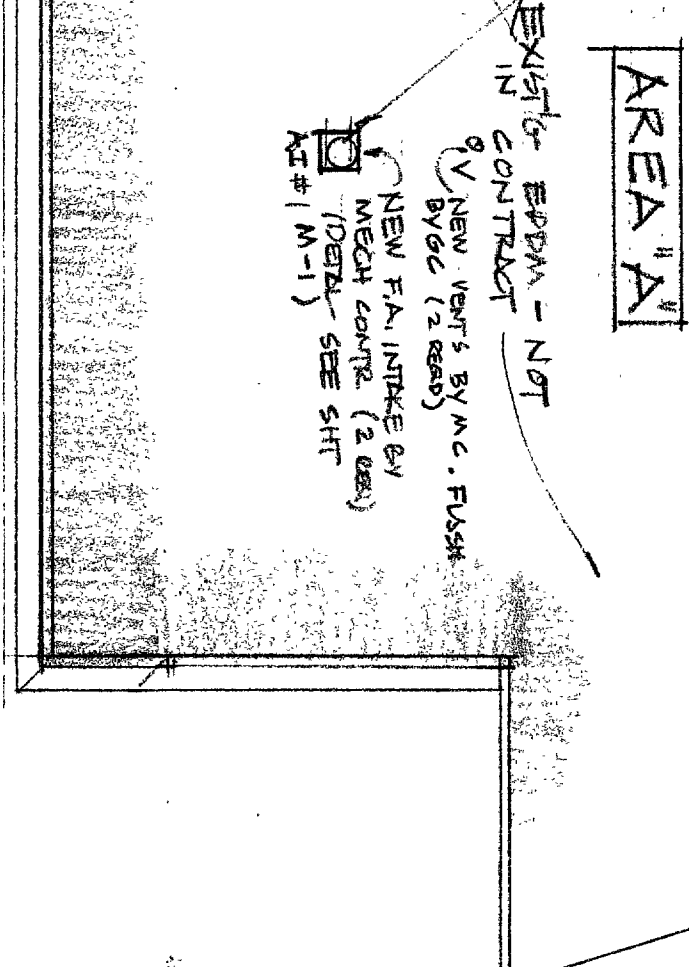

BAILLY ROOF PLANS (NEW / REROOFING)
1994 BUILDING ADDITIONS & RENOVATION PROJECTS
DUNELAND SCHOOL CORPORATION CHESTERTON, INDIANA
geromella & kinel architects, inc. chesterton, indiana