



- PLAN NOTES
 2. CONTRACTOR SHALL REMOVE EXISTING TELEPHONE DEVICES AND WIRE COMPLETE. EXISTING CONDUIT AND BOX SHALL REMAIN. CONTRACTOR SHALL INSTALL NEW CAT-3 WIRING, DEVICES AND COVERS AS INDICATED ON DRAWING.
 3. CONTRACTOR SHALL SURFACE MOUNT CONDUIT AS HIGH TO CEILING AS POSSIBLE. WHEN AVAILABLE RUN CONDUIT ABOVE ACCESSIBLE CEILING TO THE NEW CABLE TRAY.
 4. SEE WALL MOUNTED CABLE TRAY DETAIL ON DRAWING E2-D OF THIS SET.
 5. THE FOLLOWING IS A DESCRIPTION OF WIRING DEVICE TO BE INSTALLED AT EACH STATION:
a. DATA
b. DATA
c. TELEPHONE
d. SERVER
 6. CONTRACTOR SHALL RUN SURFACE MOUNTED RACEWAY FROM DEVICES TO ABOVE ACCESSIBLE CEILING. RUN CONDUIT TO WALL MOUNTED CABLE TRAY.
 11. CONTRACTOR SHALL INSTALL NEW 1-P-20A CIRCUIT BREAKER IN EXISTING PANEL "B". RUN 2 #12, #10G - 3/4" C FOR RACK POWER STRIP.

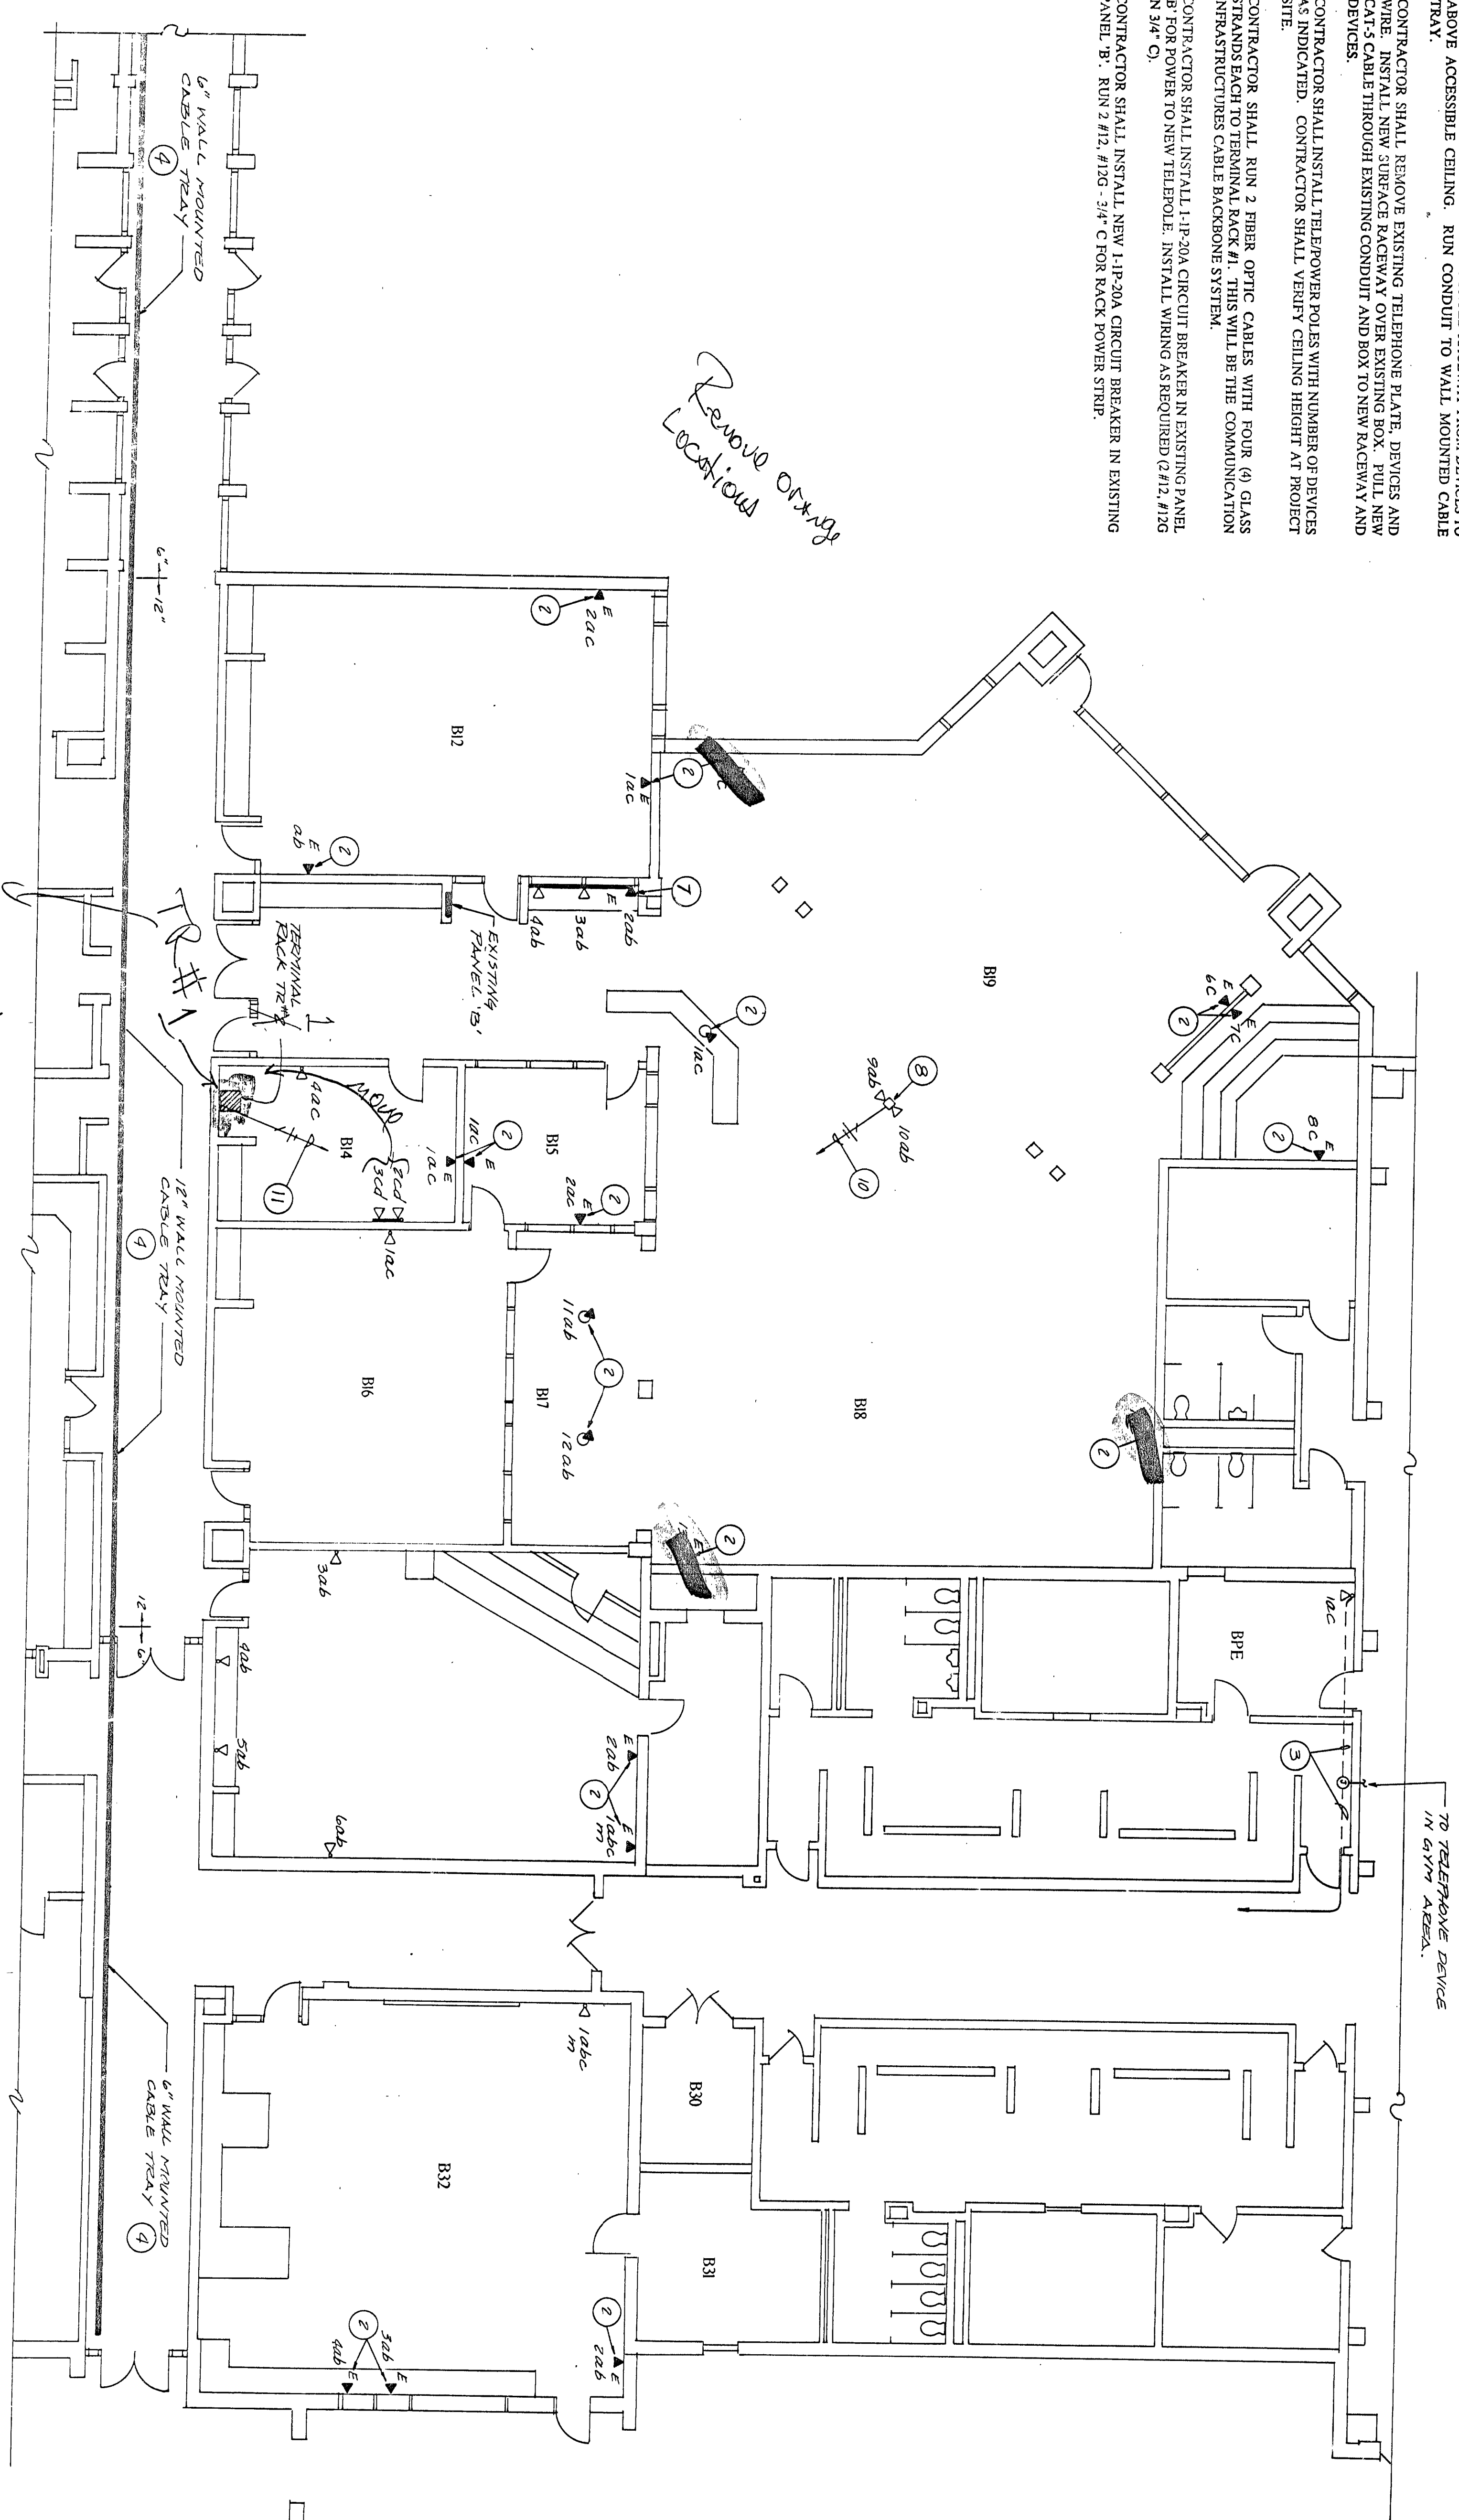

ELECTRICAL SYSTEM PLAN - UNIT B

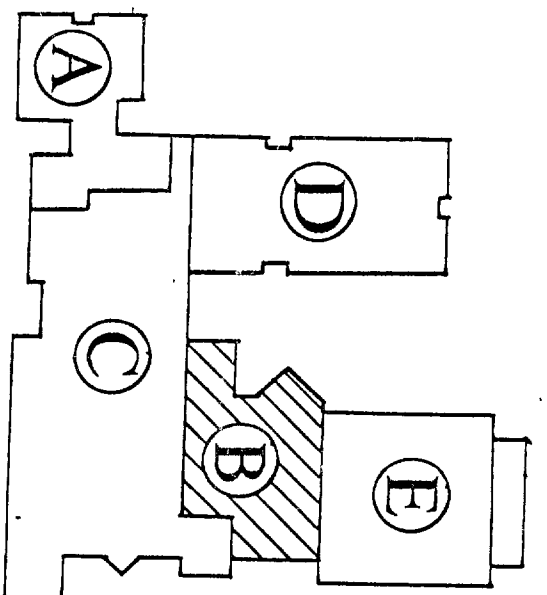

KEY PLAN

PROFESSIONAL ENGINEER
No. 13815
Indiana
PROJECT ENGINEER
CANDY L. MOORE
CERTIFIED BY
CANDY L. MOORE
PROJECT ENGINEER
REVISIONS
DATE DESCRIPTION
MARK

MOORI ENGINEER
A PROFESSIONAL CORPORATION
9245 N. Meridian Street, Suite 105
Indianapolis, Indiana 46260-1812
(317) 848-5045 FAX: (317) 848-2765

COMMUNICATIONS INFRASTRUCTURE FOR DUNELAND SCHOOL CORPORATION
DUNELAND SCHOOL CORPORATION
CHESTERION, INDIANA

TITLE
BAILEY ELEMENTARY SCHOOL
DATE 12/5/94
SCALE 1/8" = 1'-0"
SHEET NO. 9405
E2-BYE
DRAWN BY RDC