



PLAN NOTES

1. ALL STATION DEVICES ON THIS DRAWING SHALL BE ROUTED TO TERMINAL RACK NO. 1.
2. CONTRACTOR SHALL REMOVE EXISTING TELEPHONE DEVICES AND WIRE. EXISTING CONDUIT AND BOX SHALL REMAIN. CONTRACTOR SHALL INSTALL NEW CAT-5 WIRING, DEVICES AND COVERS AS INDICATED ON THIS DRAWING.
3. CONTRACTOR SHALL SURFACE MOUNT CONDUIT AS HIGH TO CEILING AS POSSIBLE. CONDUIT SHALL RUN ABOVE ACCESSIBLE CEILINGS TO THE NEW CABLE TRAY.
4. SEE WALL MOUNTED CABLE TRAY DETAIL ON DRAWING E-2 OF THIS SET.
5. THE FOLLOWING IS A DESCRIPTION OF WIRING DEVICE TO BE INSTALLED AT EACH STATION:
a. DATA
b. TELEPHONE
c. SERVER
6. CONTRACTOR SHALL RUN SURFACE MOUNTED RACEWAY FROM DEVICES TO ABOVE ACCESSIBLE CEILING. RUN CONDUIT TO WALL MOUNTED CABLE TRAY.
7. CONTRACTOR SHALL REMOVE EXISTING TELEPHONE PLATE, DEVICES AND WIRE. CONTRACTOR SHALL RUN NEW SURFACE RACEWAY ABOVE ACCESSIBLE CEILING AND CAT-5 CABLE THROUGH EXISTING CONDUIT AND BOX TO NEW RACEWAY AND DEVICES.
9. CONTRACTOR SHALL INSTALL NEW 1-P-20A CIRCUIT BREAKER IN EXISTING PANEL BLD. RUN 2 #12 AWG IN 3/4" C FOR BACK POWER STRIP.

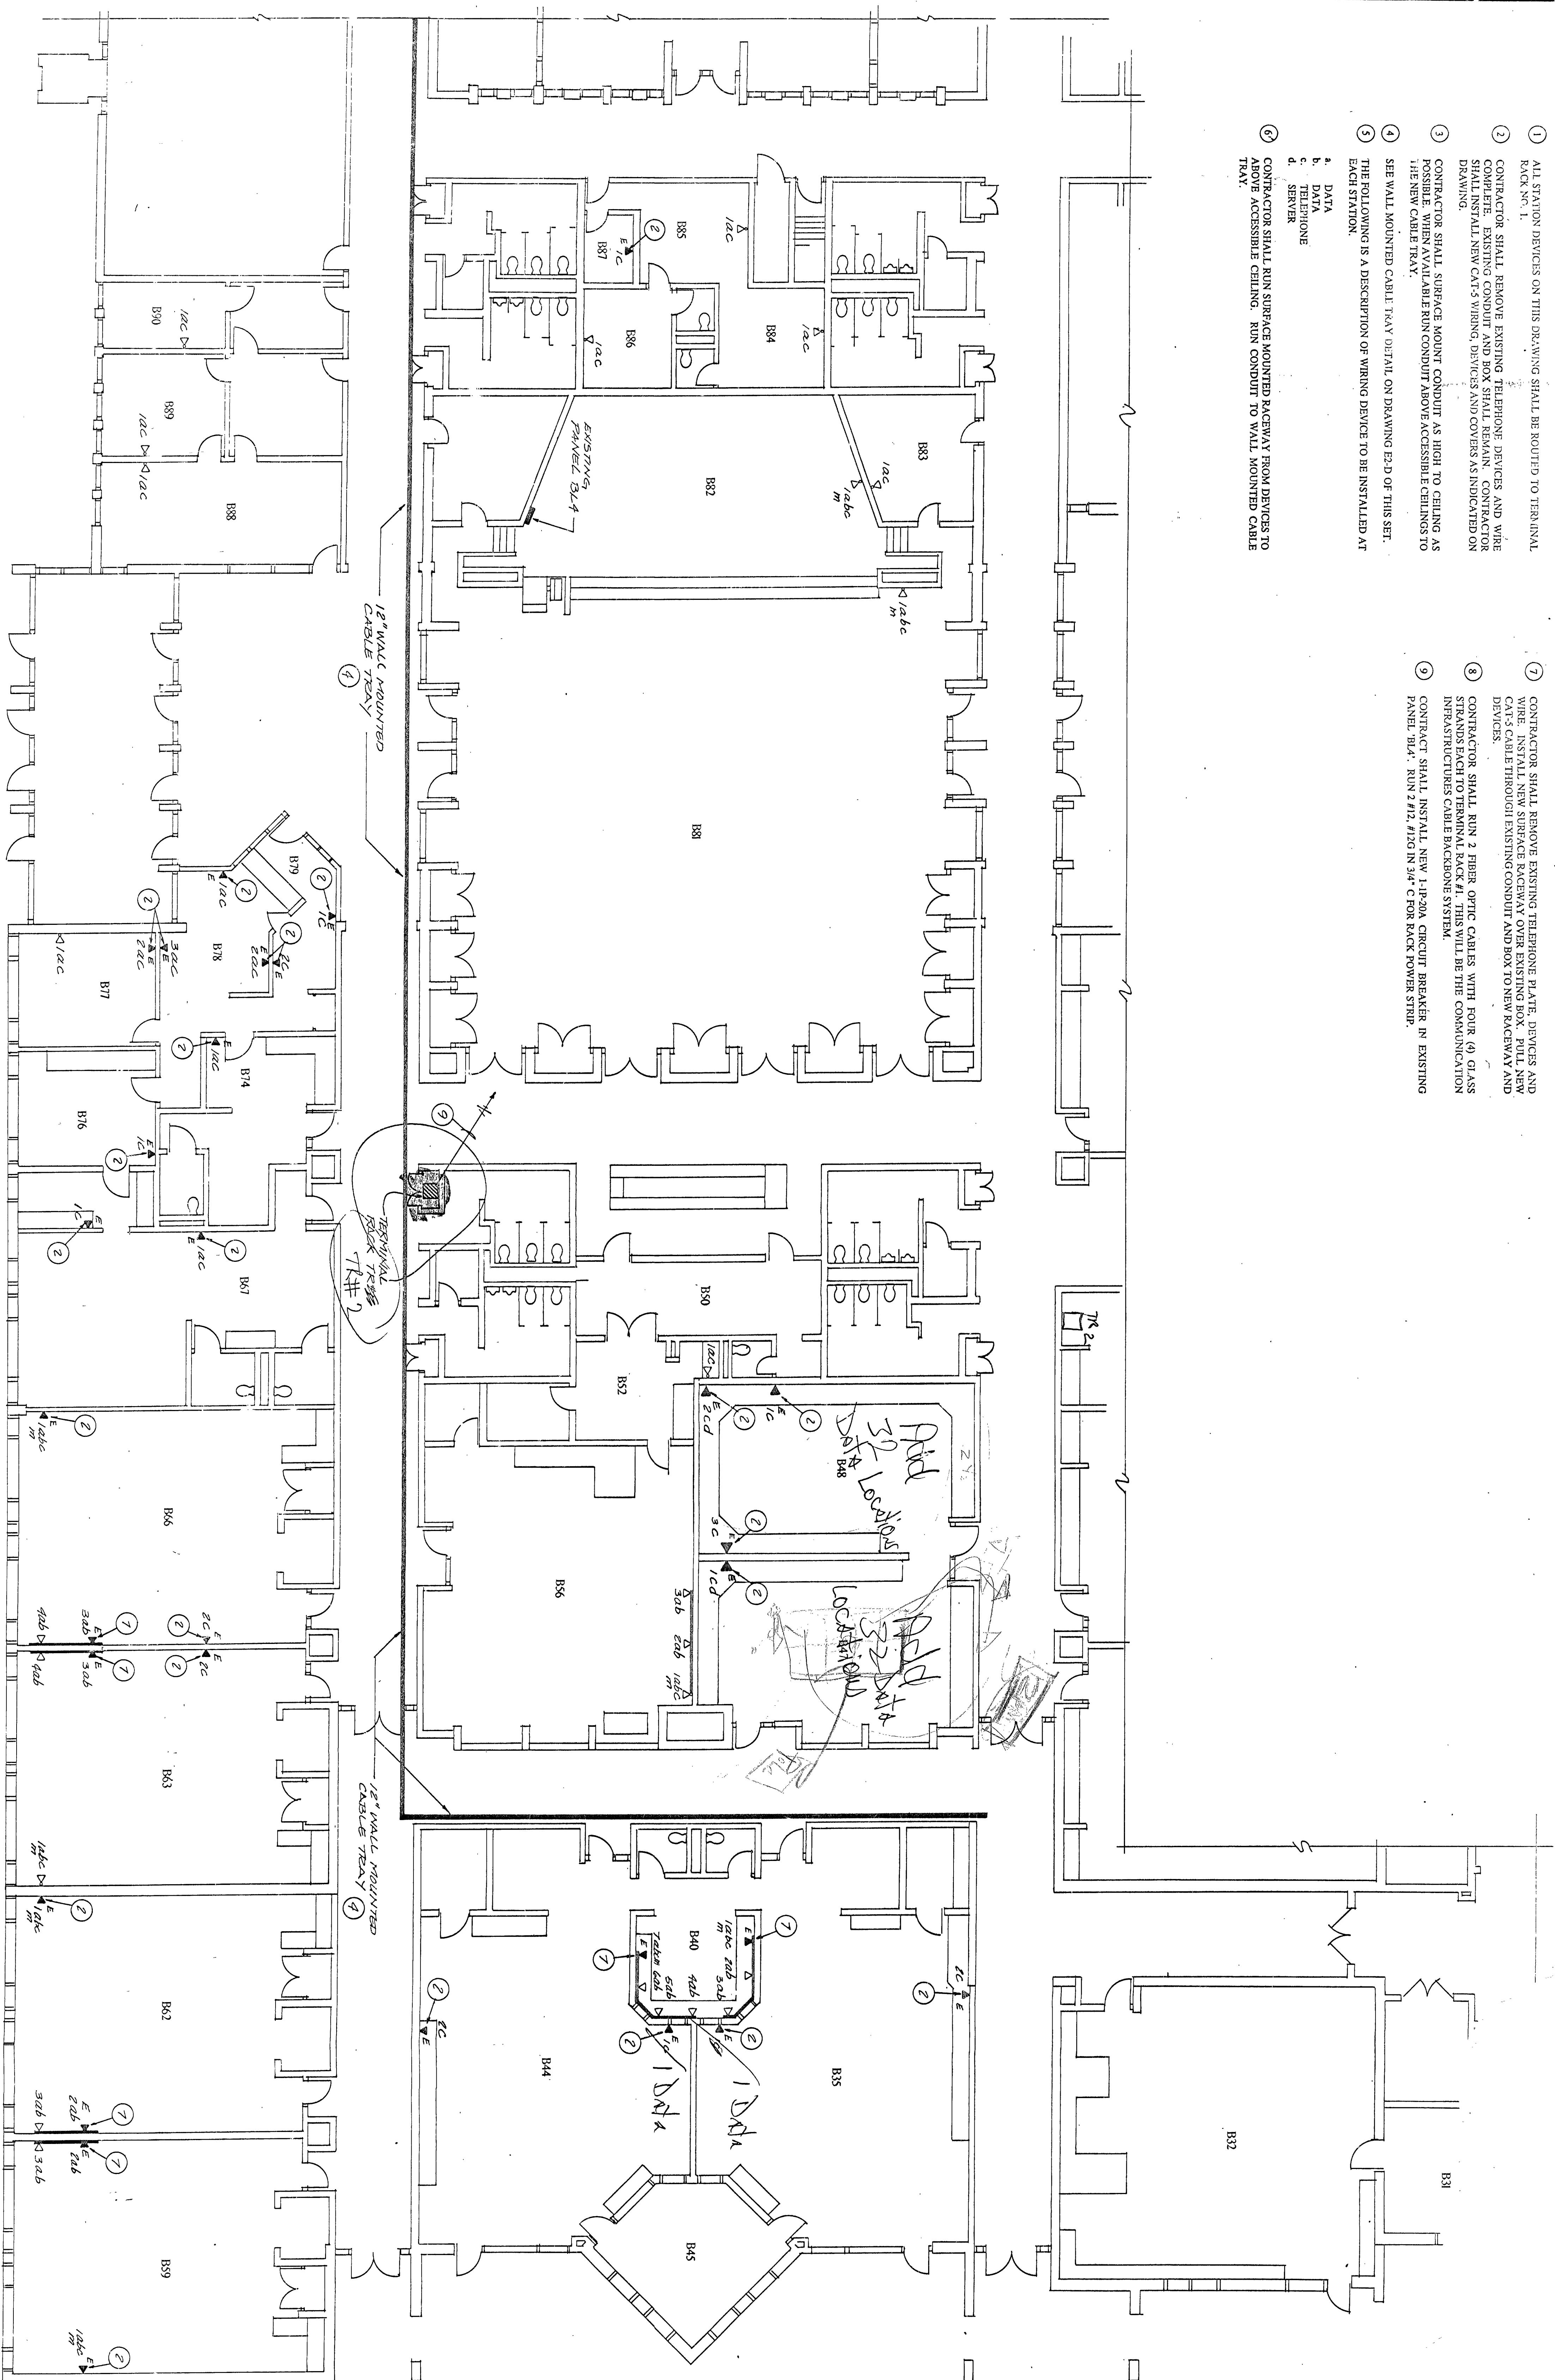

ELECTRICAL SYSTEM PLAN - UNIT C

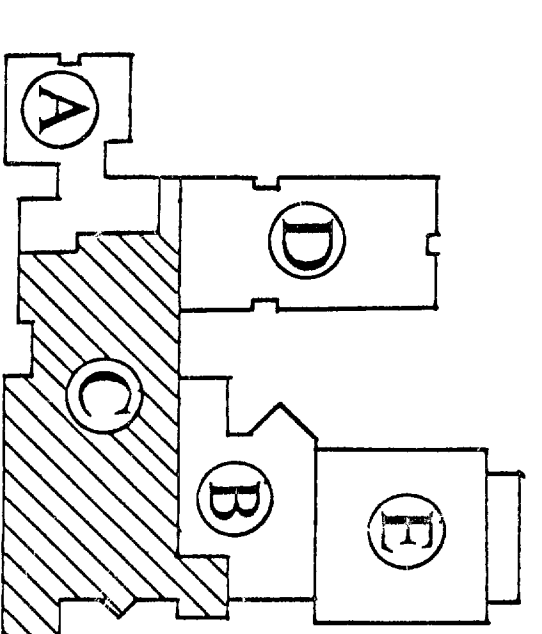

KEY PLAN

MOOR ENGINEER
A PROFESSIONAL CORP.
9245 N. Meridian Street, Suite
Indianapolis, Indiana 46260-3013
(317) 848-5045 FAX: (317) 84

**COMMUNICATI
INFRASTRUCT
FOR DUNELA
SCHOOL CORPO**

**BAILEY
ELEMENTAR
SCHOOL**

**DUNELAND SCH
CORPORATION
CHESTERTON, IN**

DATE: 12/5/94
SCALE: 1/8" = 1'-0"
COMM. NO.: 94034
DESIGNER: R.D.C.

SHEET NO.: E3