


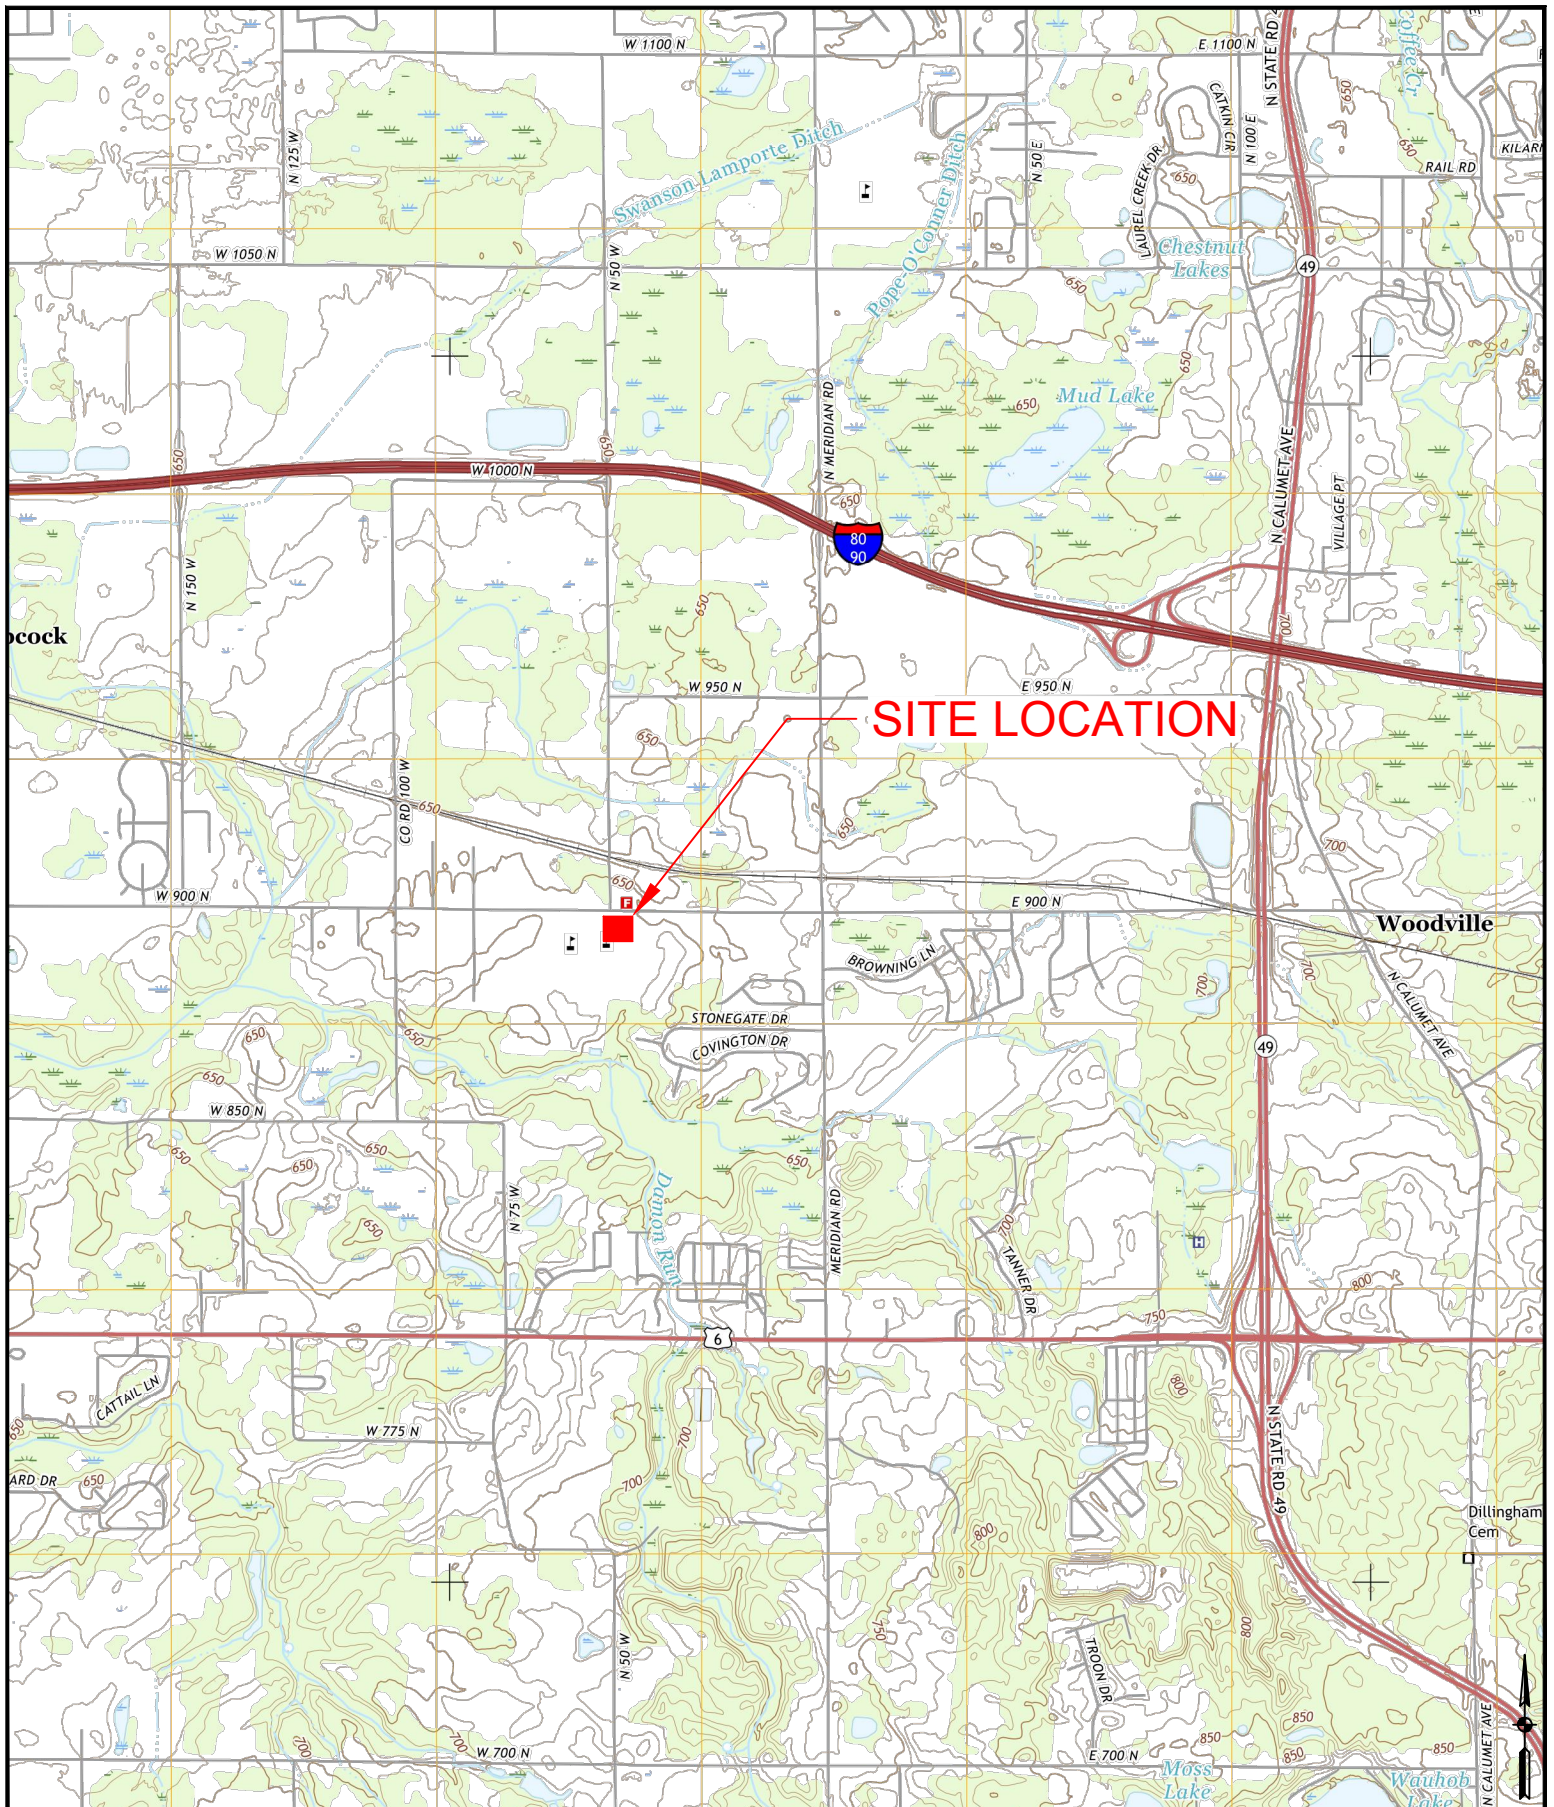

SHEET 1 OF 4

DRAWING NUMBER

SP1

SITE LOCATION MAP

GROUND PENETRATING RADAR
LIBERTY INTERMEDIATE SCHOOL, 50 W. 900 N.

CHESTERTON

INDIANA


DRAWN: N. SCHUR
DESIGNED: S. TRAVIS
APPROVD: S. TRAVIS
DATE: APR. 16, 2018
PROJECT NUMBER:
18.4033.1

NO.	REVISION	BY	DATE
1			
2			
3			
4			
5			
6			
7			
8			
9			
10			



AMERECO, INC.

CONSULTING ENGINEERS-PROJECT MANAGERS
54 MICHIGAN AVENUE
VALPARAISO, IN 46383 219-531-0531

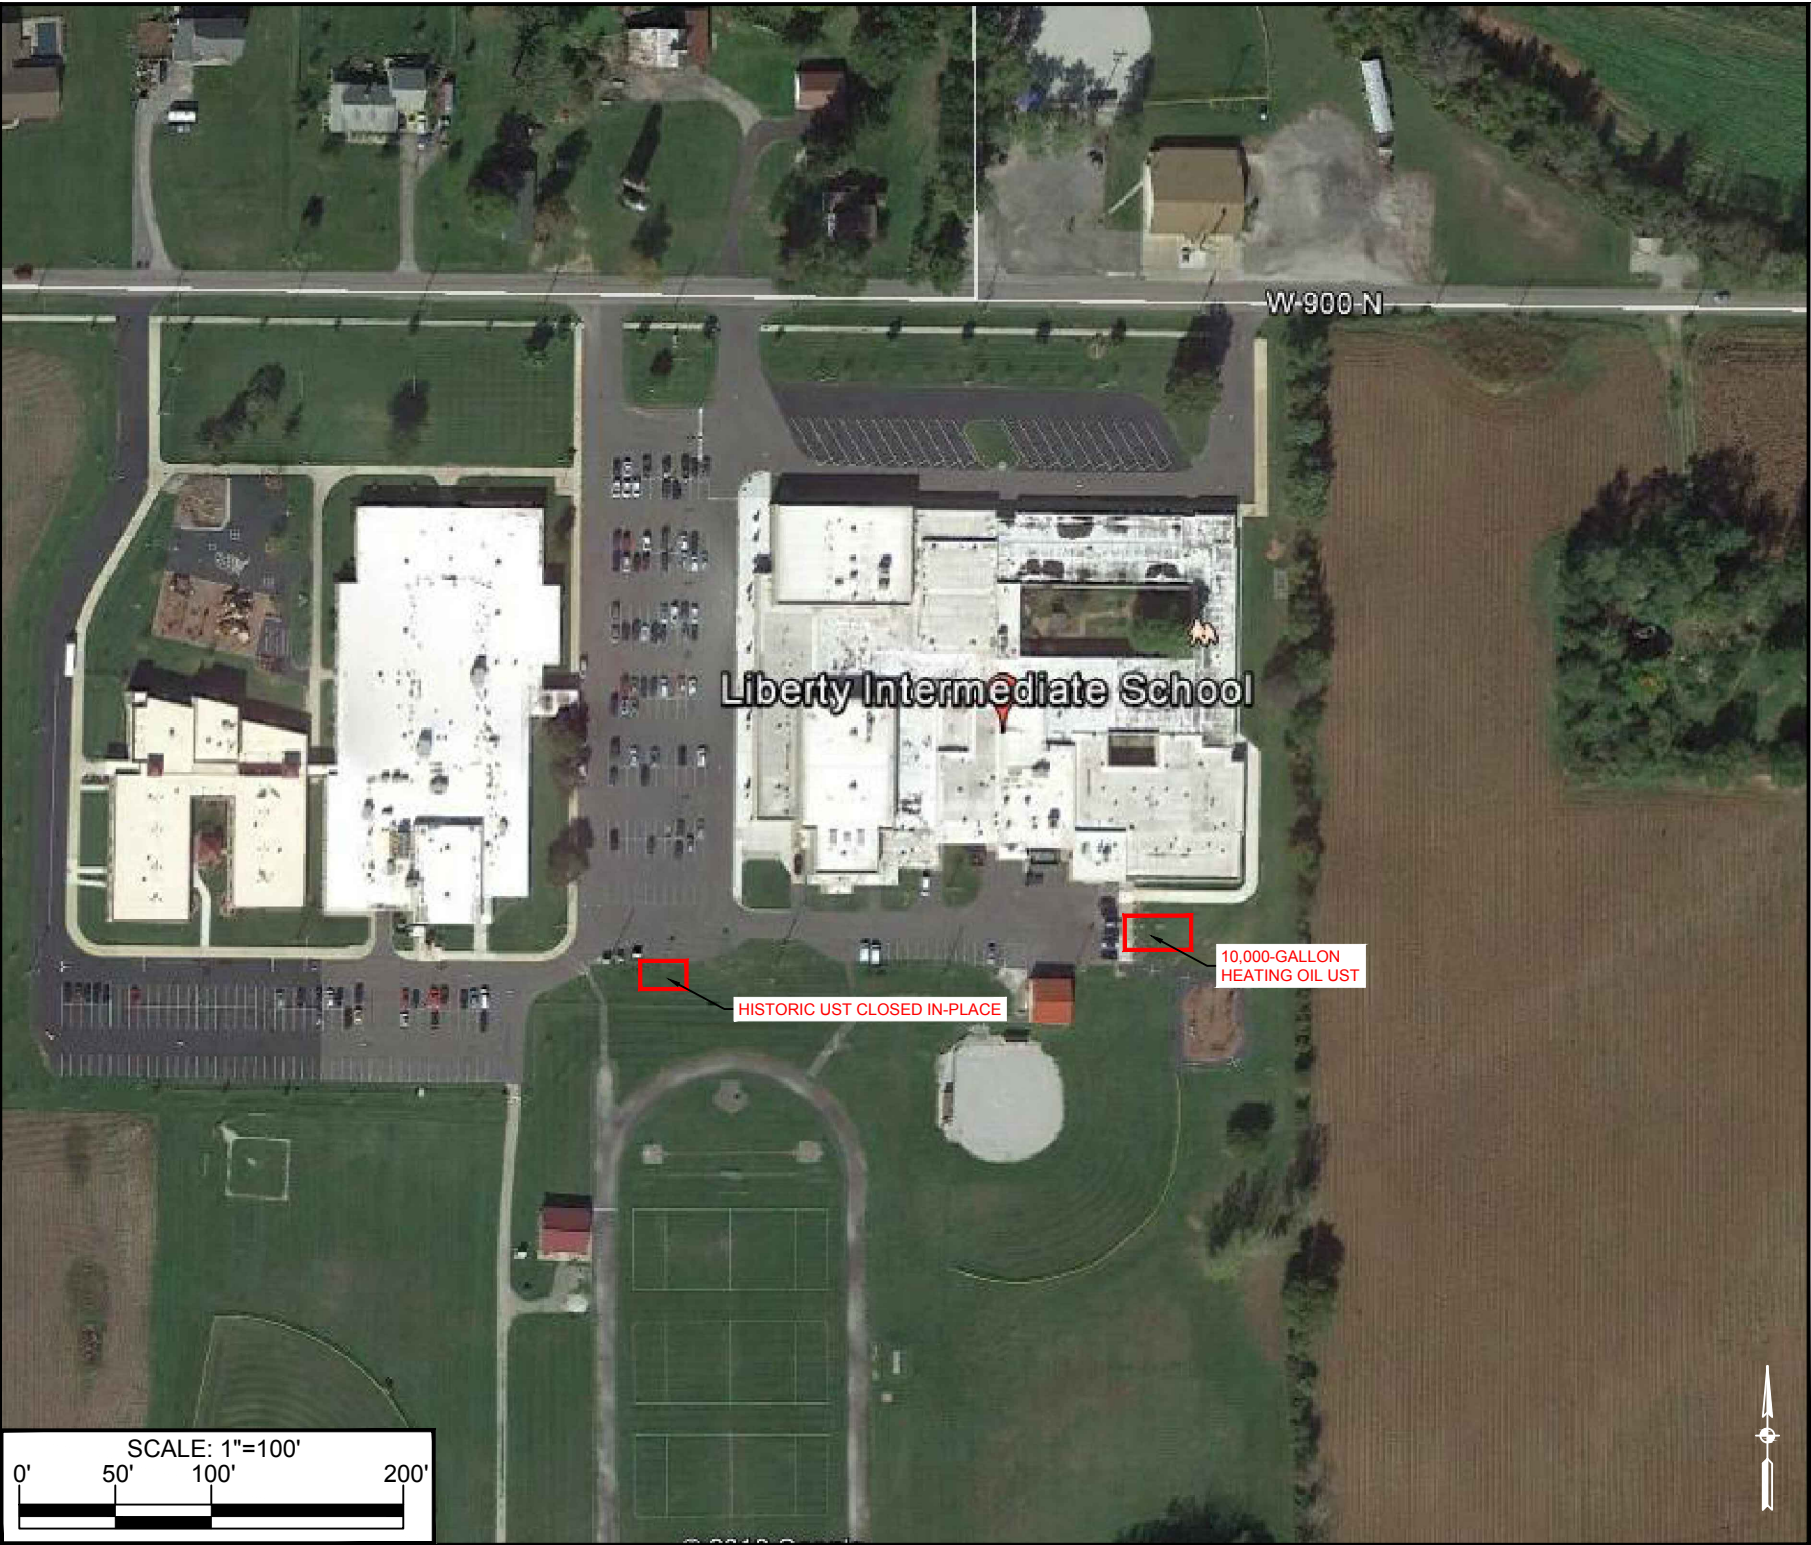


Liberty Intermediate School

W-900-N

10,000-GALLON
HEATING OIL UST

HISTORIC UST CLOSED IN-PLACE

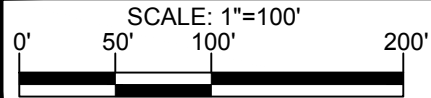

SITE PLAN

SHEET 2 OF 4
DRAWING NUMBER
SP2


GROUND PENETRATING RADAR
LIBERTY INTERMEDIATE SCHOOL, 50 W. 900 N.
CHESTERTON INDIANA

DRAWN: N. SCHIR
DESIGNED: S. TRAVIS
APPROVED: S. TRAVIS
DATE: FEB 21, 2017
PROJECT NUMBER:
18.4033.1

NO.	REVISION	BY	DATE



AMERESCO, INC.
CONSULTING ENGINEERS-PROJECT MANAGERS
54 MICHIGAN AVENUE
VALPARAISO, IN 46383 219-531-0531

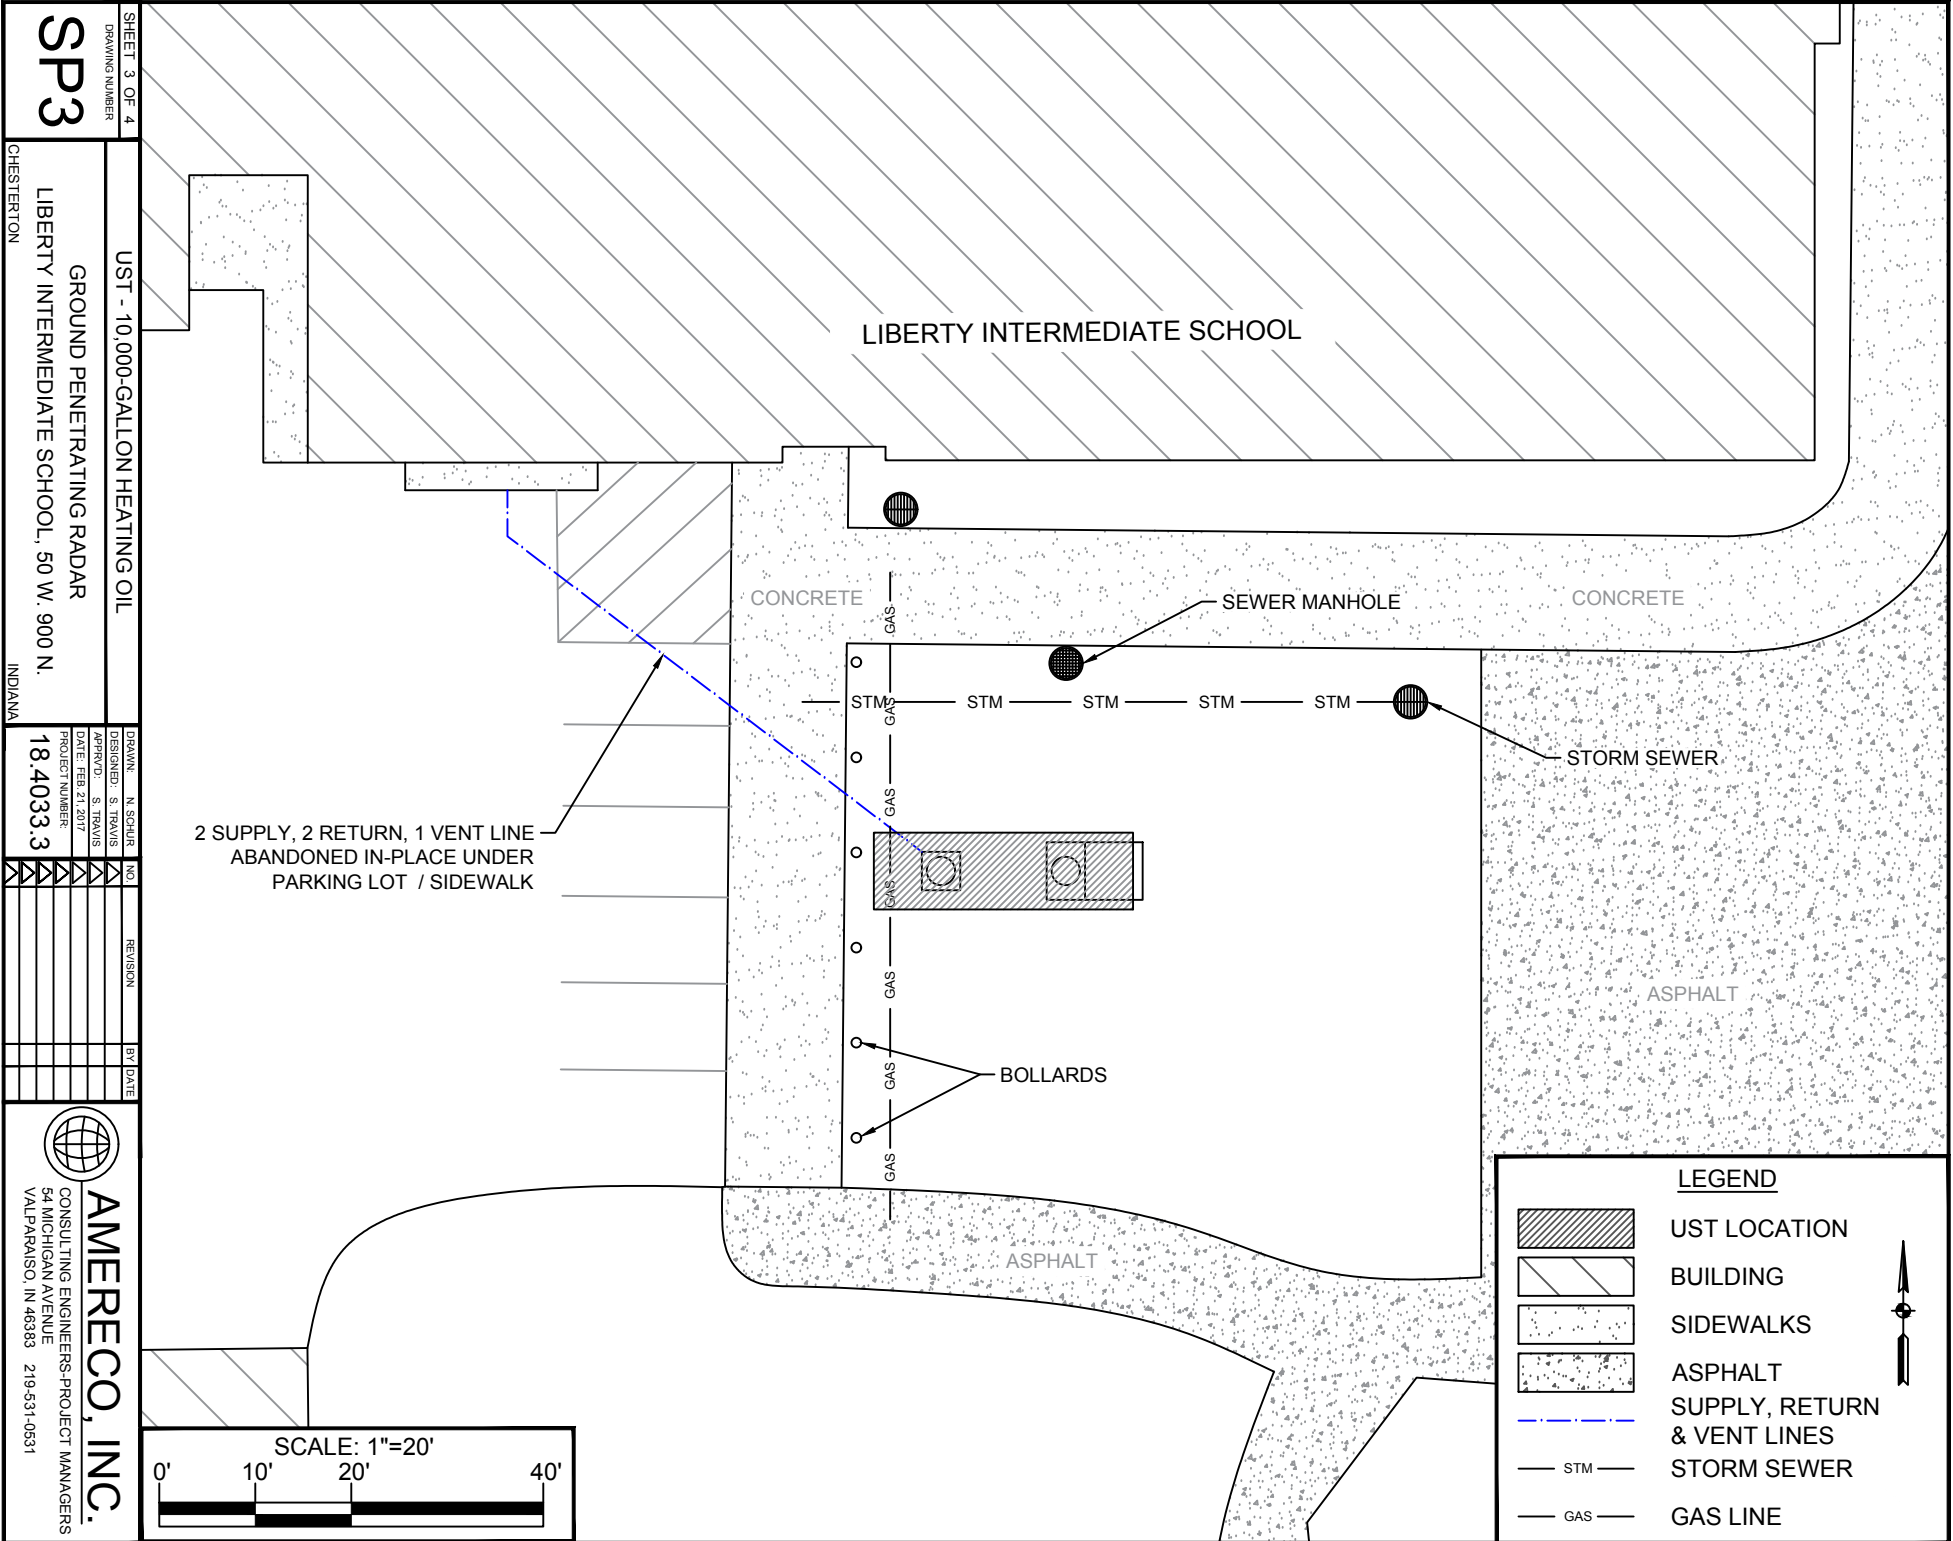

SHEET 3 OF 4
DRAWING NUMBER
SP3

UST - 10,000-GALLON HEATING OIL
GROUND PENETRATING RADAR
LIBERTY INTERMEDIATE SCHOOL, 50 W. 900 N.
CHESTERTON INDIANA

DRAWN: N. SCHIR
DESIGNED: S. TRAVIS
APPROVED: S. TRAVIS
DATE: FEB 21, 2017
PROJECT NUMBER:
18.4033.3

NO.	REVISION	BY	DATE
1			
2			
3			
4			
5			
6			
7			
8			
9			
10			

SHEET 4 OF 4

DRAWING NUMBER

SP4

HISTORIC UST CLOSED IN-PLACE

GROUND PENETRATING RADAR

LIBERTY INTERMEDIATE SCHOOL, 50 W. 900 N.

CHESTERTON

INDIANA

DRAWN: N. SCHUB

DESIGNED: S. TRAVIS

APPROVED: S. TRAVIS

DATE: FEB 21, 2017

PROJECT NUMBER:

18.4033.1

NO.

REVISION

BY

DATE



AMERESCO, INC.

CONSULTING ENGINEERS-PROJECT MANAGERS

54 MICHIGAN AVENUE

VALPARAISO, IN 46383 219-531-0531

